IREDELL COUNTY HEALTH DEPARTMENT

STATESVILLE 704-878-5305 — MOORESVILLE 704-663-3647

Revised Garage

IMPROVEMENT PERMIT / AUTHORIZATION TO CONSTRUCT / OPERATION PERMIT / EXISTING SYSTEM INSPECTION

PERMIT# 105093 PIN# 4740-40-6325 179535 DATE 3/12/02

OWNER OR CONTRACTOR Billy Adams PHONE: Business _____ Home 704-875-0723

ADDRESS 14109 Eastfield Rd. Huntersville, NC 28078

LOCATION I-5 N, TL Flowerhouse, TL Carlyle, Lot on Rt.

SUBDIVISION Carlyle Farms BLOCK / SECTION 2 LOT 18 LOT AREA 5.12 Ac. SITE CLASS. PS DESIGN FLOW 480 L.T.A.R. 0.4

Septic Tank: 1000 Gallons; STB 99 Date 10/15/01

Pump Tank: _____ Gallons; PT _____ Date _____

Pump Make: _____ Model _____ Serial No. _____

Nitrification Field: No Fields 1 Square Feet 1200 Linear Feet 400

No Lines 3@33' Trench Width 36" Max Trench Bottom Depth 36" Gravel Depth 12"

☒ New System ☐ Repair System Type: I (II) III. IV. V. VI

System Description: Gravity Conventional Trench

Repair System Description: _____

Maintenance Agreement Required: ☐ Yes ☒ No

☒ House/Mod. Home ☐ Mobile Home ☐ Business ☐ Other

No. Bedrooms 4 No. Bathrooms 2 No. Employees _____


☐ Slab ☒ Crawl Space ☐ Basement w/plumbing ☐ Basement wo/plumbing

Water Supply: ☒ Individual ☐ Public ☐ Community


Comments/Conditions:

Comments/Conditions:

INITIAL SITE SKETCH

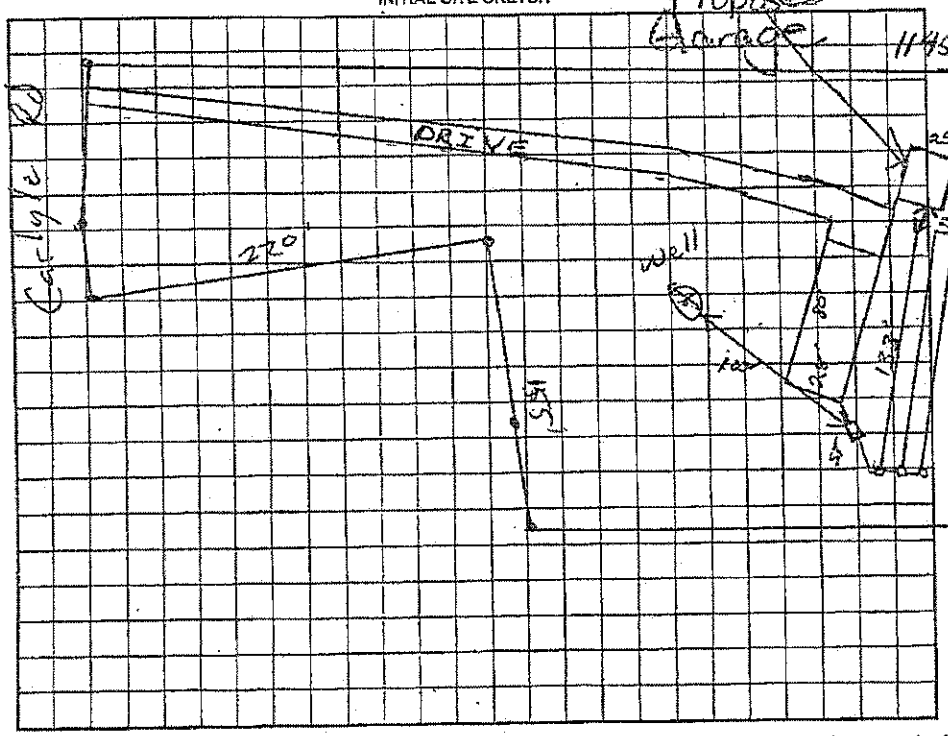

AS BUILT SKETCH

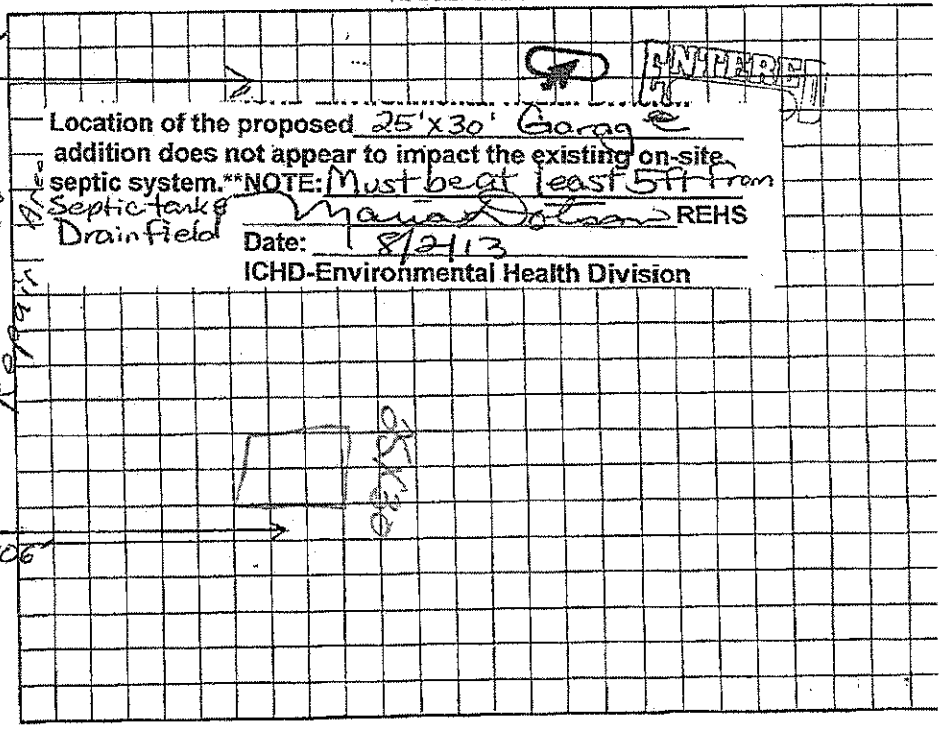

Permit can be suspended or revoked if any false information is supplied toward securing the permit/any unauthorized changes are made to the site/any unauthorized changes are made in the installation of the system. Improvement Permit with plat valid without expiration. Improvement Permit with site plan valid for sixty months. Authorization to Construct is valid for a period equal to that of Improvement Permit – not to exceed sixty months.

Signed: Melissa Adams date 3-13-02 Installed by: WT Norwood

Improvement Permit by: _____ RS date 3/22/02 Operation Permit by: Wesley Sparks RS. date 4/19/02

Authorization to Construct by: _____ RS date 3/12/02 Existing System Inspection by: _____ date _____

HEALTH DEPT. COPY: WHITE OWNER COPY (FINAL): YELLOW OWNER COPY (INITIAL): PINK