IREDELL COUNTY HEALTH DEPARTMENT

STATESVILLE 704-878-5305 MOORESVILLE 704-664-5281

IMPROVEMENT PERMIT / AUTHORIZATION TO CONSTRUCT / OPERATION PERMIT / EXISTING SYSTEM INSPECTION

PERMIT# 105093 PIN# 4740-40-6325 DATE 3/12/02

OWNER OR CONTRACTOR Billy Adams PHONE: Business Home 704-875-0723

ADDRESS 14109 Eastfield Rd. Huntersville, NC 28078

LOCATION 115N, TL Flower house, TL Carlyle, Lot on Rt.

SUBDIVISION Carlyle Farms BLOCK / SECTION 2 LOT 18 LOT AREA 5.72 Ac. SITE CLASS PS DESIGN FLOW 480 L.T.A.R. 0.4

Septic Tank: 1000 Gallons; STB 97 Date 10/15/01

Pump Tank: Gallons; PT Date

Pump Make: Model Serial No.

Nitrification Field: No Fields 1 Square Feet 1200 Linear Feet 400

No Lines 30/33' Trench Width 36" Max Trench Bottom Depth 36" Gravel Depth 12"

[X] New System [ ] Repair System Type: I, II, III, IV, V, VI

System Description: Gravity Conventional

Repair System Description: Same

Maintenance Agreement Required: [ ] Yes [X] No

[X] House/Mod. Home No. Bedrooms 4

[ ] Mobile Home No. Bathrooms 2

[ ] Business No. Employees

[ ] Other


[ ] Slab [X] Crawl Space [ ] Basement w/plumbing [ ] Basement wo/plumbing

Water Supply: [X] Individual [ ] Public [ ] Community


Comments:/Conditions:

Comments:/Conditions:

INITIAL SITE SKETCH

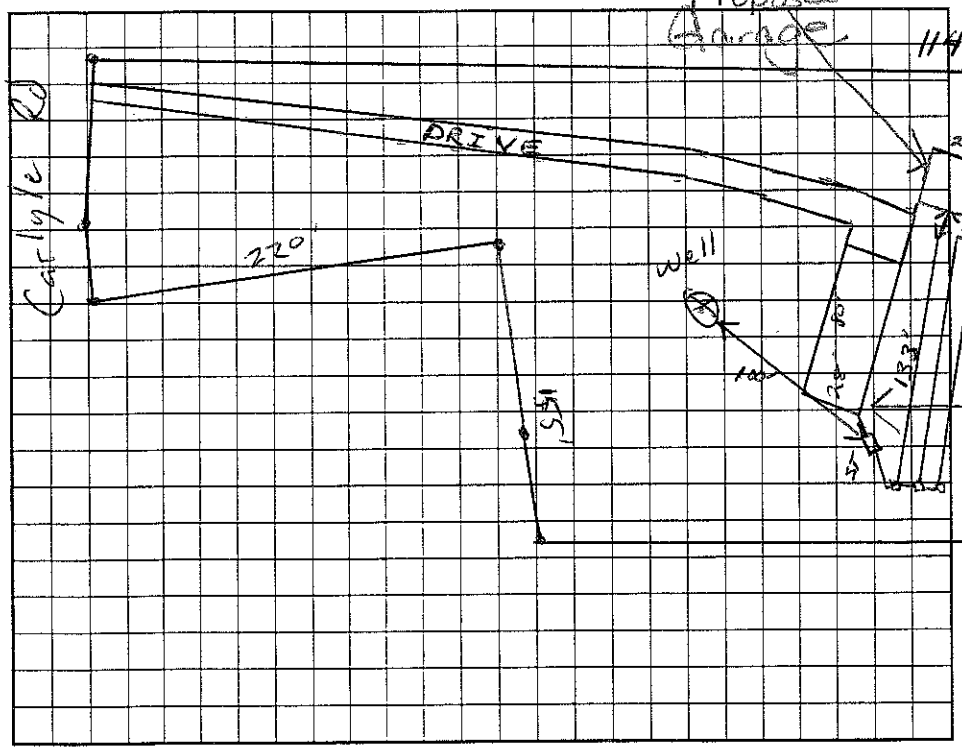

AS BUILT SKETCH

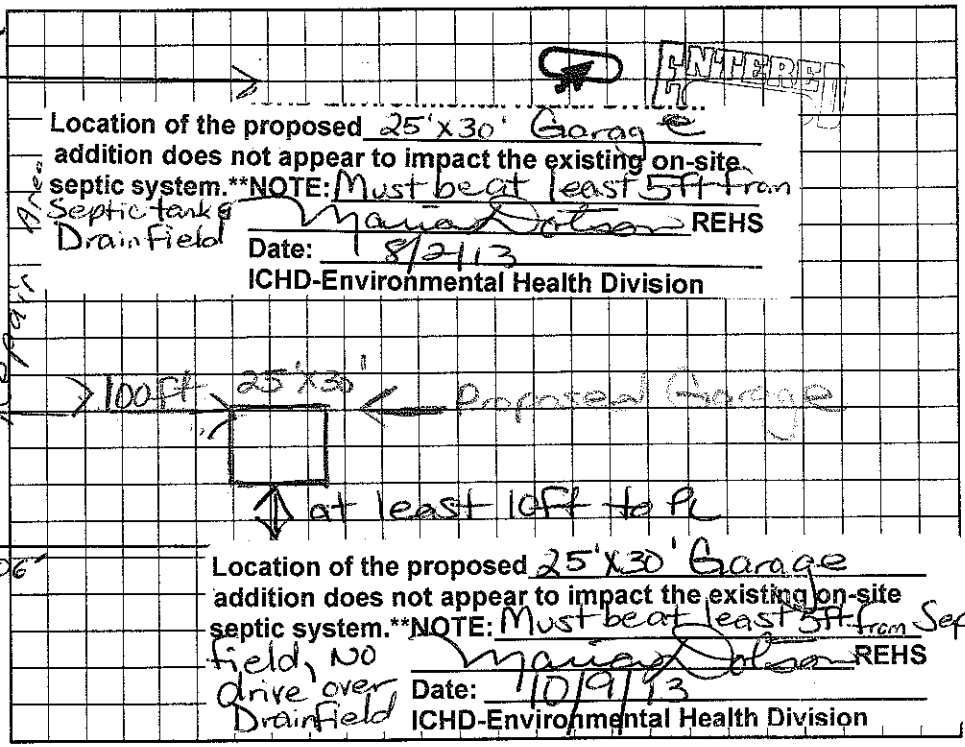

Permit can be suspended or revoked if any false information is supplied toward securing the permit/any unauthorized changes are made to the site/any unauthorized changes are made in the installation of the system. Improvement Permit with plat valid without expiration. Improvement Permit with site plan valid for sixty months. Authorization to Construct is valid for a period equal to that of Improvement Permit – not to exceed sixty months.

Signed: Melissa Adams date 3-13-02

Improvement Permit by: RS date 3/12/02

Authorization to Construct by: RS date 3/12/02

Installed by: WT Norwood

Operation Permit by: Wesley Sparks RS. date 4/19/02

Existing System Inspection by: date

HEALTH DEPT. COPY: WHITE OWNER COPY (FINAL): YELLOW OWNER COPY (INITIAL): PINK