3:30

IREDELL COUNTY HEALTH DEPARTMENT

STATESVILLE 704-878-5305 125.00 Paid MOORESVILLE 704-664-5281

IMPROVEMENT PERMIT / AUTHORIZATION TO CONSTRUCT / OPERATION PERMIT / EXISTING SYSTEM INSPECTION

PERMIT# 091262 PIN# ~~4740 203493~~ 4740412027 DATE 1-19-2001

OWNER OR CONTRACTOR AH Inc / Spears Construction PHONE: Business (704) 636-7765 Home

ADDRESS 2310 S. Main St. Salisbury, NC 28147

LOCATION Clontz Hill Rd. TR Ridge Creek TR Wiltshire TL Panther Creek ON Rt Near End

SUBDIVISION Wiltshire Creek BLOCK / SECTION LOT 27 LOT AREA .65 Acre SITE CLASS. PS DESIGN FLOW 360gpd L.T.A.R. .3

Septic Tank: 1000 Gallons; STB 825 Date 12/18/00
Pump Tank: Gallons; PT Date
Pump Make: Model Serial No.
Nitrification Field: No Fields 1 Square Feet 900' Linear Feet 300'
No Lines 4 at 75' Trench Width 36" Max Trench Bottom Depth 36" Gravel Depth N/A

[X] New System [ ] Repair System Type: I, II, (III), IV, V, VI
System Description: Gravity - 25% Reduction
Repair System Description: Gravity Innovative
Maintenance Agreement Required: [ ] Yes [ ] No

[X] House/Mod. Home [ ] Mobile Home [ ] Business [ ] Other
No. Bedrooms 3 No. Bathrooms 2 No. Employees


[ ] Slab [X] Crawl Space [ ] Basement w/plumbing [ ] Basement wo/plumbing

Water Supply: [X] Individual [ ] Public [ ] Community


Comments:/Conditions: Keep Septic System 10' from PL, 5' from House & 50' from any well.

Comments:/Conditions: Note: Installer Needs to install lines on contour. Okay to use Distribution box or "Drop boxes"

INITIAL SITE SKETCH Scale 1:50

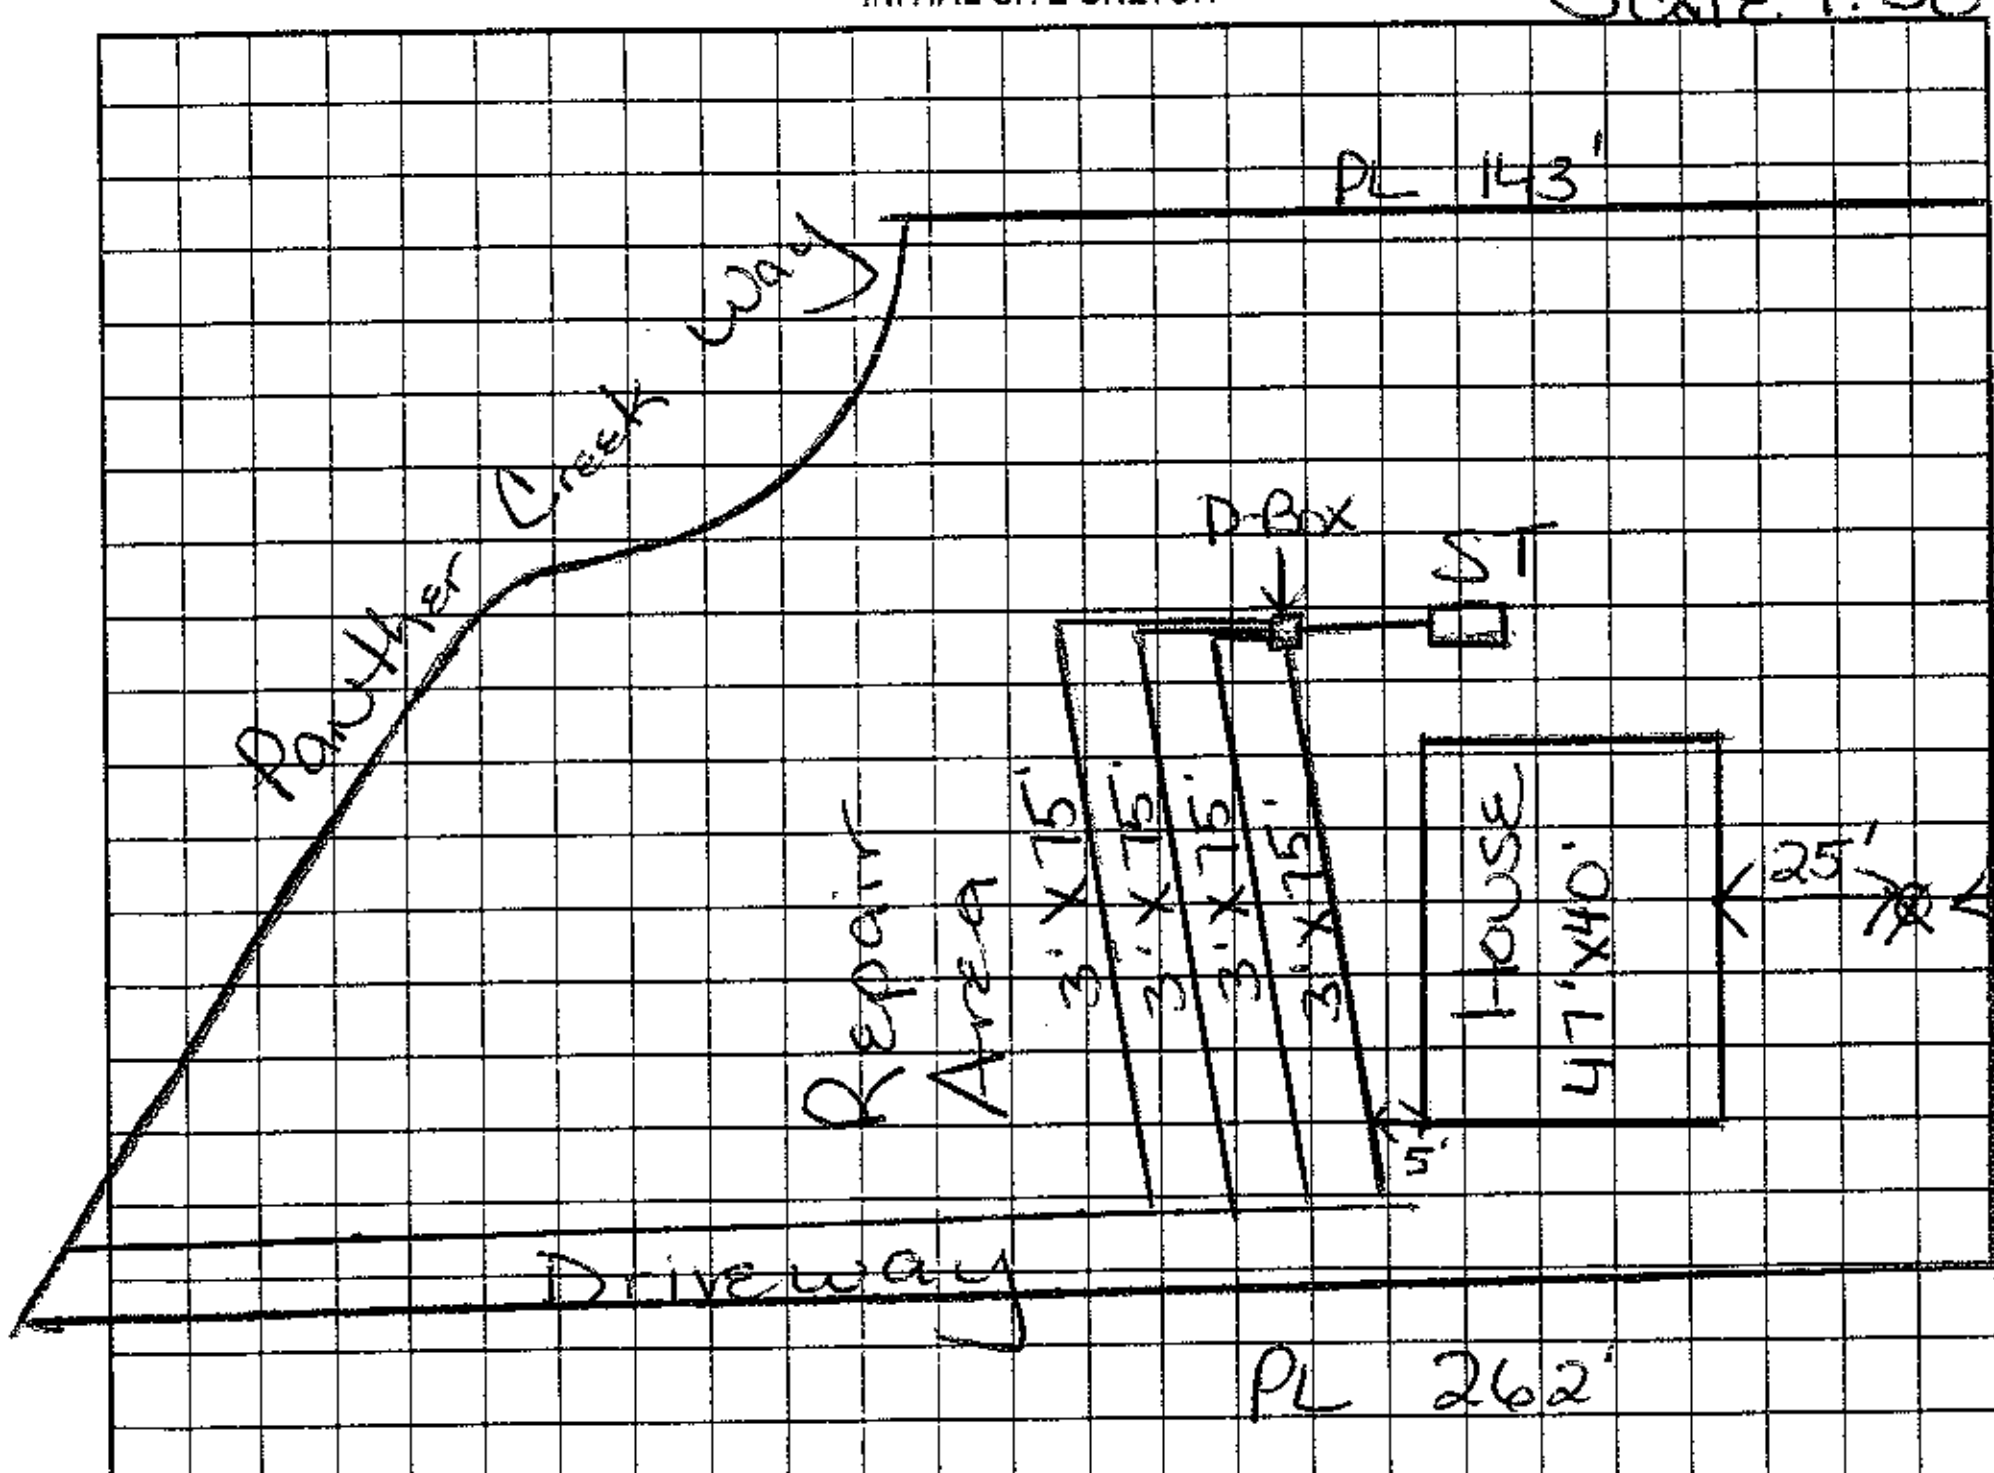

AS BUILT SKETCH

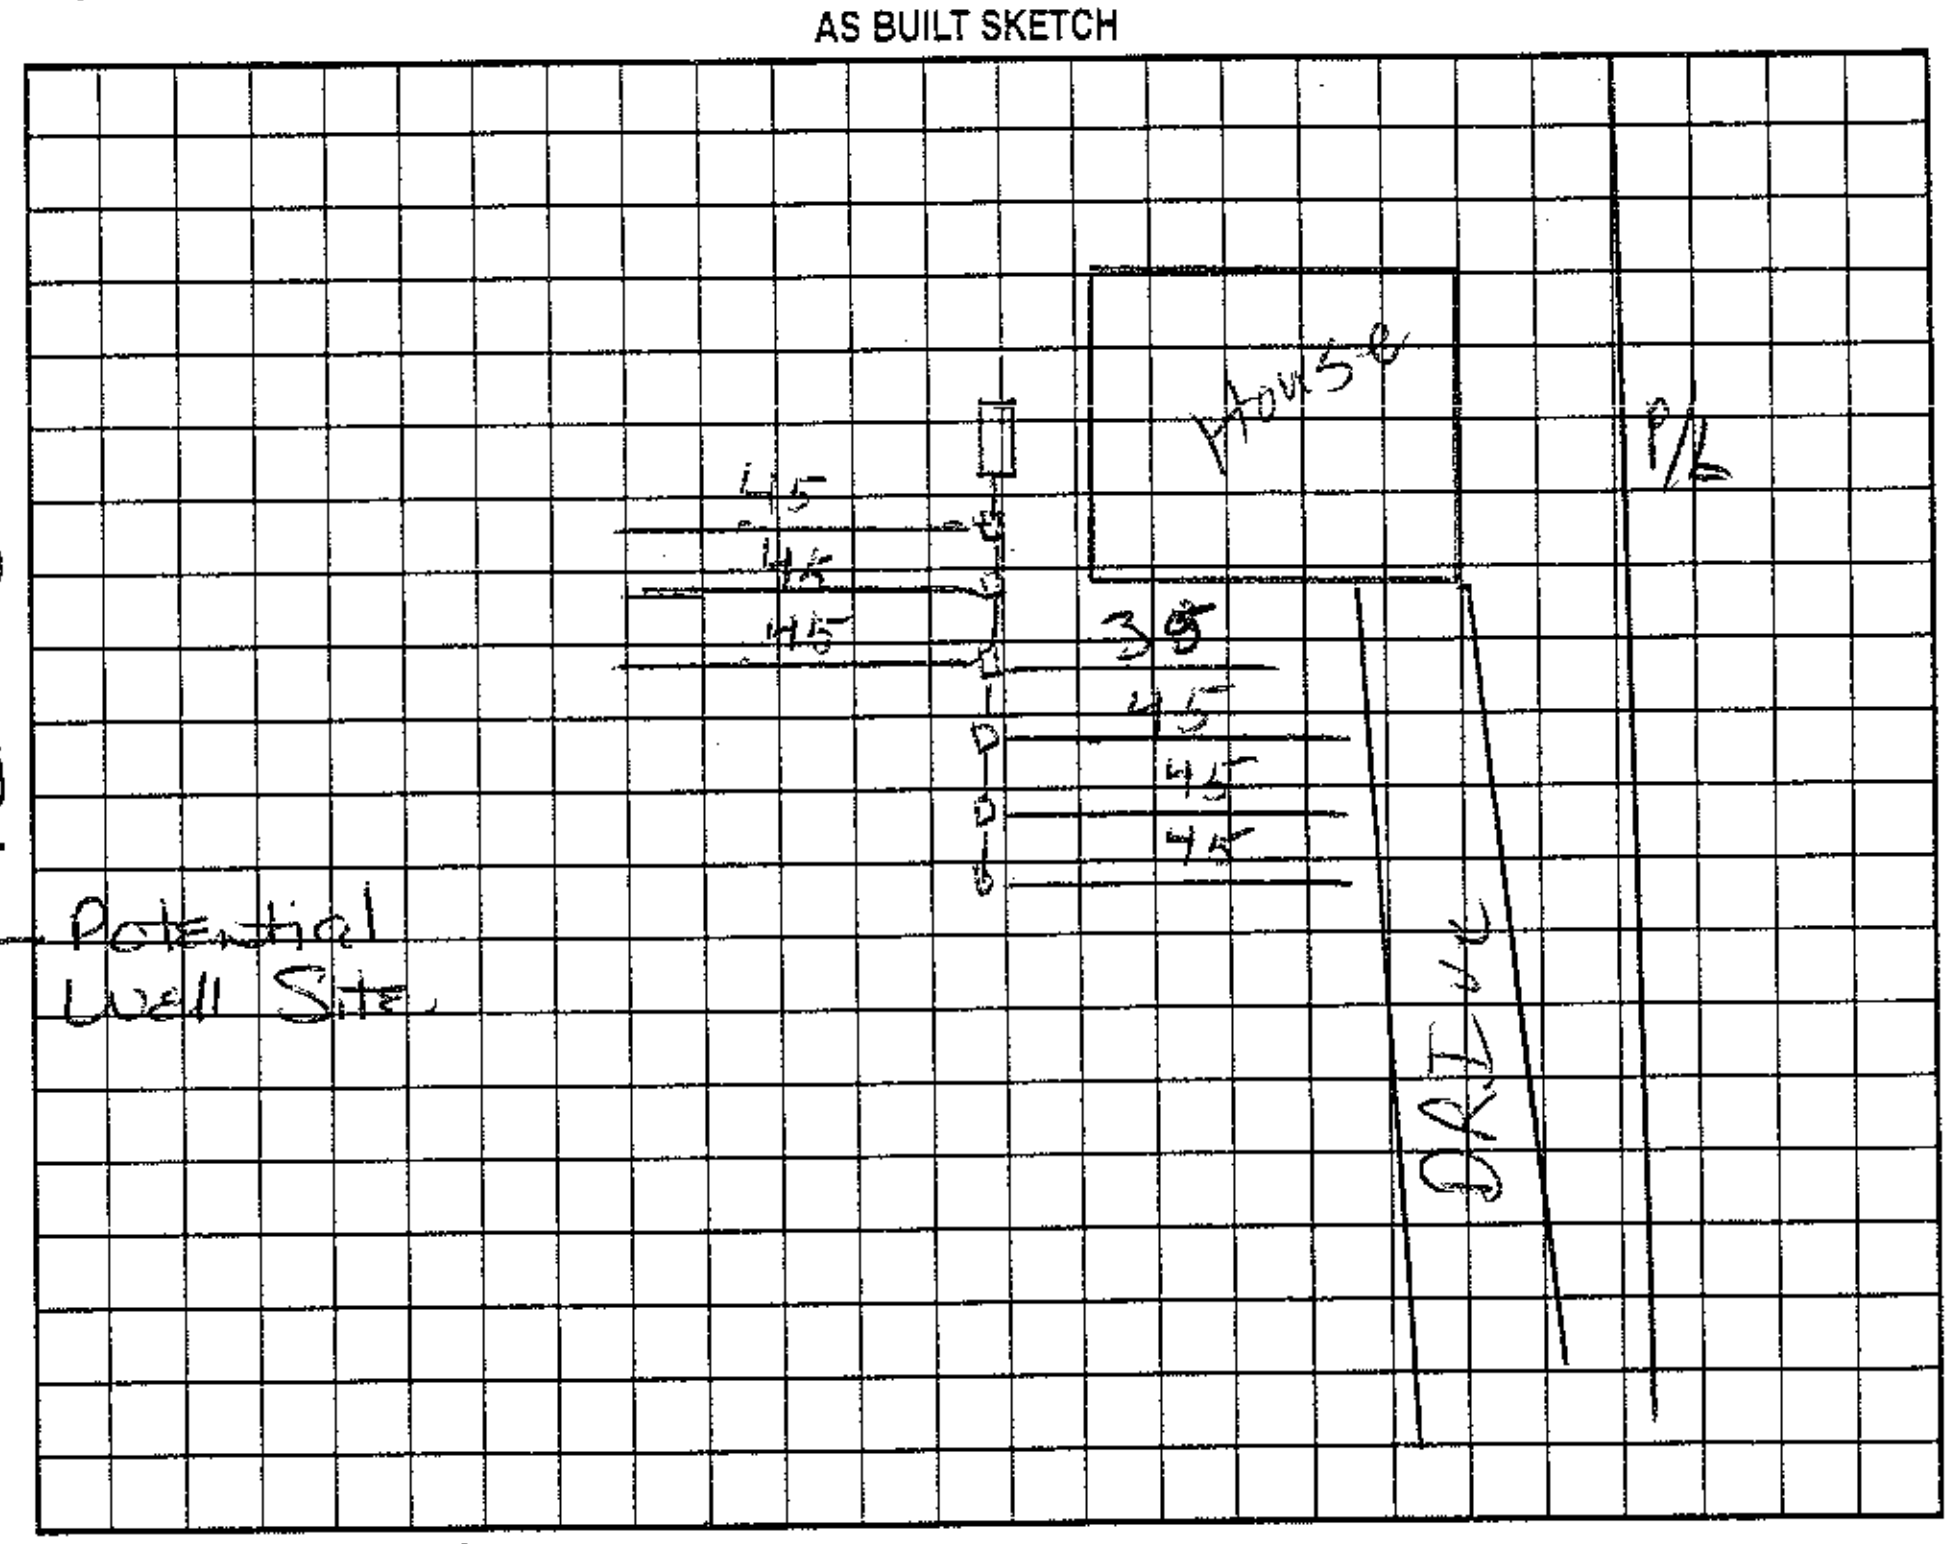

Permit can be suspended or revoked if any false information is supplied toward securing the permit/any unauthorized changes are made to the site/any unauthorized changes are made in the installation of the system. Improvement Permit with plat valid without expiration. Improvement Permit with site plan valid for sixty months. Authorization to Construct is valid for a period equal to that of Improvement Permit – not to exceed sixty months.

Signed: [signature] date 1/22/01 Installed by: Rowan Septic

Improvement Permit by: Marc H. Dobson RS date 1/19/2001 Operation Permit by: [signature] RSI date 3/9/01

Authorization to Construct by: Marc H. Dobson RS date 1/19/2001 Existing System Inspection by: date

HEALTH DEPT. COPY: WHITE OWNER COPY (FINAL): YELLOW OWNER COPY (INITIAL): PINK