3:00 - Rowan Septic

# IREDELL COUNTY HEALTH DEPARTMENT

STATESVILLE 704-878-5305 MOORESVILLE 704-664-5281

## IMPROVEMENT PERMIT / AUTHORIZATION TO CONSTRUCT / OPERATION PERMIT / EXISTING SYSTEM INSPECTION

PERMIT# 090661 PIN# ~~4740 20 3493~~ 4740412267 DATE 8/9/00

OWNER OR CONTRACTOR AH Inc PHONE: Business (704) 636-7765 Home

ADDRESS 2310 S Main ST Salisbury NC 28147

LOCATION Perth, TR Clontz Hill, TR Ridge Crk, TR Wiltshire, TL Panther Crk at End

SUBDIVISION Wiltshire Crk BLOCK / SECTION LOT 26 LOT AREA .96 AC SITE CLASS. PS DESIGN FLOW 360 L.T.A.R. 0.3

Septic Tank: 1000 Gallons; STB 825 Date 8/26/00
Pump Tank: Gallons; PT Date
Pump Make: Model Serial No.
Nitrification Field: No Fields 1 Square Feet 1200 Linear Feet 400
No Lines 5 Drop Trench Width 36" Max Trench Bottom Depth 24" Gravel Depth 12"

☒ New System ☐ Repair System Type: I, II, III, IV, V, VI
System Description: Gravity Conventional
Repair System Description: Pump Conventional
Maintenance Agreement Required: ☐ Yes ☒ No

☒ House/Mod. Home ☐ Mobile Home ☐ Business ☐ Other
No. Bedrooms 3 No. Bathrooms 2 No. Employees


☒ Slab ☐ Crawl Space ☐ Basement w/plumbing ☐ Basement wo/plumbing

Water Supply: ☒ Individual ☐ Public ☐ Community

Comments:/Conditions: ~~Boxes~~
Keep well 100' from septic system

Comments:/Conditions:

INITIAL SITE SKETCH

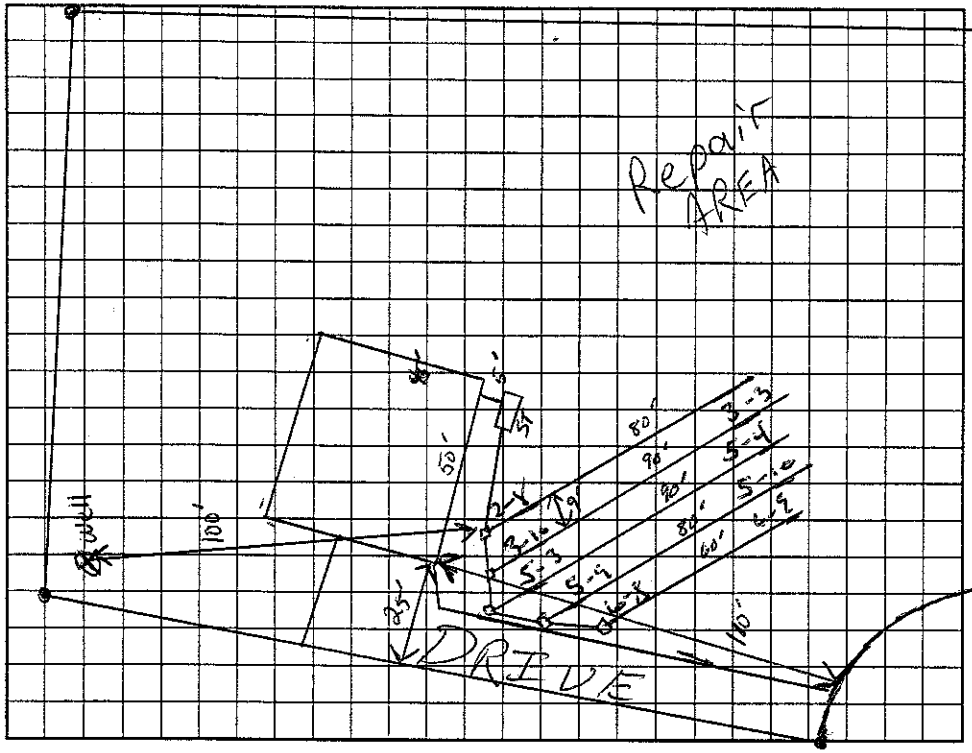


AS BUILT SKETCH

Permit can be suspended or revoked if any false information is supplied toward securing the permit/any unauthorized changes are made to the site/any unauthorized changes are made in the installation of the system. Improvement Permit with plat valid without expiration. Improvement Permit with site plan valid for sixty months. Authorization to Construct is valid for a period equal to that of Improvement Permit – not to exceed sixty months.

Signed: date 8/10/00

Improvement Permit by: RSI date 8/9/00

Authorization to Construct by: RSI date 8/9/00

Installed by: B Rowan Septic Tank

Operation Permit by: Wesley Sparks RS date 9/28/00

Existing System Inspection by: date

HEALTH DEPT. COPY: WHITE OWNER COPY (FINAL): YELLOW OWNER COPY (INITIAL): PINK