IREDELL COUNTY HEALTH DEPARTMENT

STATESVILLE 704-878-5305 MOORESVILLE 704-664-5281

IMPROVEMENT PERMIT / AUTHORIZATION TO CONSTRUCT / OPERATION PERMIT / EXISTING SYSTEM INSPECTION

PERMIT# 135585 PIN# 4740 41 4463

OWNER OR APPLICANT Corinthian Bldrs.

ADDRESS PO Box 190 Denver, NC 28037 PHONE: Business _____ Home _____ DATE 5/8/06

LOCATION 115N, TL Flowerhouse, TL Carlyle, TR Farmdale, TR Holmfield on Lt

SUBDIVISION Carlyle Farms BLOCK / SECTION 3 LOT 41 LOT AREA 0.507AC SITE CLASS PS DESIGN FLOW 360 L.T.A.R. 0.3

Septic Tank: 1000 Gallons; STB 786 Date 4/10/06

Pump Tank: _____ Gallons; PT _____ Date _____

Pump Make: _____ Model _____ Serial No. _____

Nitrification Field: No Fields 1 Square Feet 900 Linear Feet 300

No Lines 4@75 Trench Width 36" Max Trench Bottom Depth 36"

☒ New System ☐ Repair ☐ Expansion System Type: I II III IV V VI

System Description: 25% Reduction

Repair System Description: Same

Maintenance Agreement Required: ☐ Yes ☒ No

Gravel Depth — ☒ Gravity ☐ Pressure

☒ House/Mod. Home ☐ Mobile Home ☐ Business ☐ Other

No. Bedrooms 3 No. Persons ___ No. Employees ___

Water Supply: ☒ Individual ☐ Public ☐ Community


☐ Slab ☒ Crawl Space ☐ Basement w/plumbing ☐ Basement wo/plumbing

Comments:/Conditions:

1"=50'

Comments:/Conditions:

INITIAL SITE SKETCH

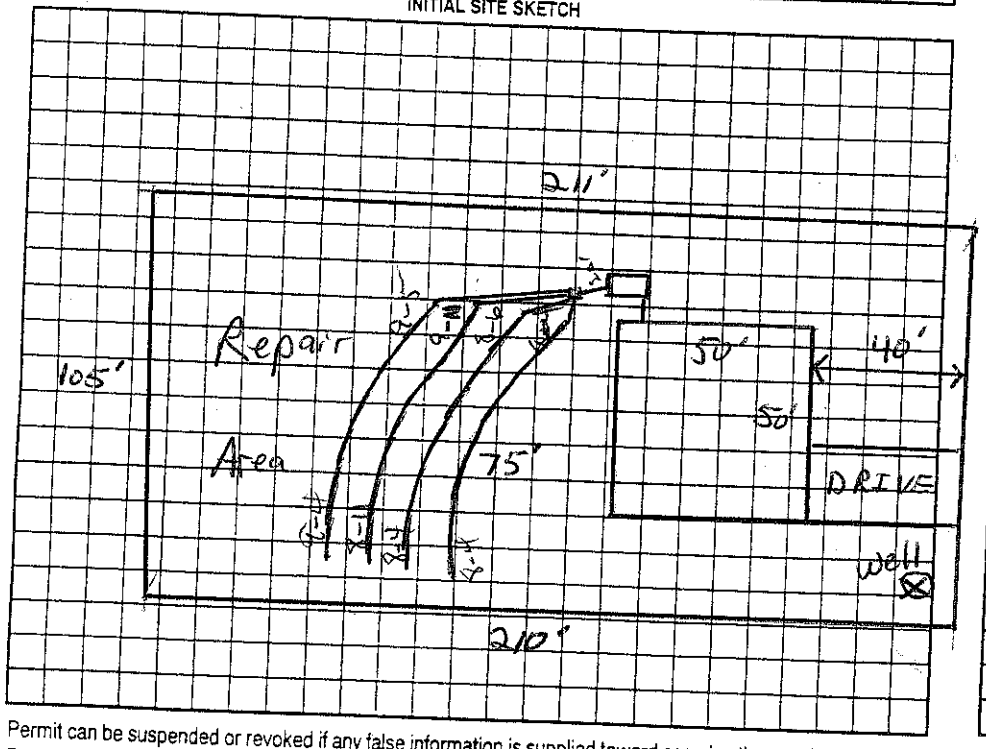

AS BUILT SKETCH

Permit can be suspended or revoked if any false information is supplied toward securing the permit/any unauthorized changes are made to the site/any unauthorized changes are made in the installation of the system. Improvement Authorization to Construct is valid for a period equal to that of Improvement Permit – not to exceed sixty months.

Permit with plat valid without expiration ☐ Improvement Permit with site plan valid for sixty months ☒

Signed: _____ date 5-10-01

Improvement Permit by: _____ RS date 5/8/06

Authorization to Construct by: _____ RS date 5/8/06

Installed by: Corinthian Bldrs.

Operation Permit by: Wesley Sparks RS. date 7/10/06

Existing System Inspection by: _____ date _____

HEALTH DEPT COPY: WHITE OWNER COPY (FINAL): YELLOW OWNER COPY (INITIAL): PINK