IREDELL COUNTY HEALTH DEPARTMENT

VILLE 704-878-5305 Ø MOORESVILLE 704-664-5281

IMPROVEMENT PERMIT / AUTHORIZATION TO CONSTRUCT / OPERATION PERMIT / EXISTING SYSTEM INSPECTION

PERMIT# 133035 PIN# 4740 41 4563 DATE 12/22/05

OWNER OR CONTRACTOR Corinthian Bldrs. PHONE: Business _____ Home _____

ADDRESS PO Box 990 Denver NC 28037

LOCATION 115 N, TL Flowers House, TL Carlyle, TR Farmdale, TR Holmfield, on Lt

SUBDIVISION Carlyle Farms BLOCK / SECTION 3 LOT 4 LOT AREA 0.51ac SITE CLASS P3 DESIGN FLOW 360 L.T.A.R. 0.3

Septic Tank: 1000 Gallons; STB _____ Date _____

Pump Tank: _____ Gallons; PT _____ Date _____

Pump Make: _____ Model _____ Serial No. _____

Nitrification Field: No Fields 1 Square Feet 900 Linear Feet 300

No Lines 4 Trench Width 36" Max Trench Bottom Depth 36"

☒ New System ☐ Repair System Type: I II III IV V VI

System Description: Gravity 25% Reduct.

Repair System Description: Same

Maintenance Agreement Required: ☐ Yes ☒ No

Gravel Depth —

☒ House/Mod. Home ☐ Mobile Home ☐ Business ☐ Other

No. Bedrooms 3 No. Bathrooms ____ No. Employees ____

☐ Slab ☒ Crawl Space ☐ Basement w/plumbing ☐ Basement wo/plumbing


Water Supply: ☒ Individual ☐ Public ☐ Community

Comments:/Conditions:


Comments:/Conditions:

1" = 40'

INITIAL SITE SKETCH

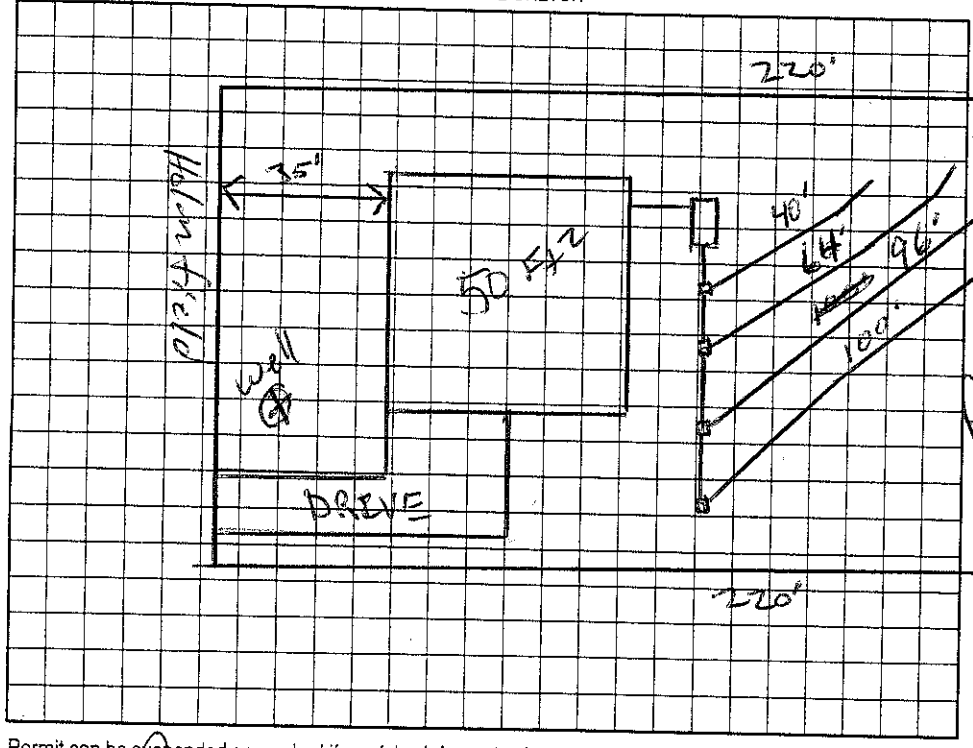

AS BUILT SKETCH

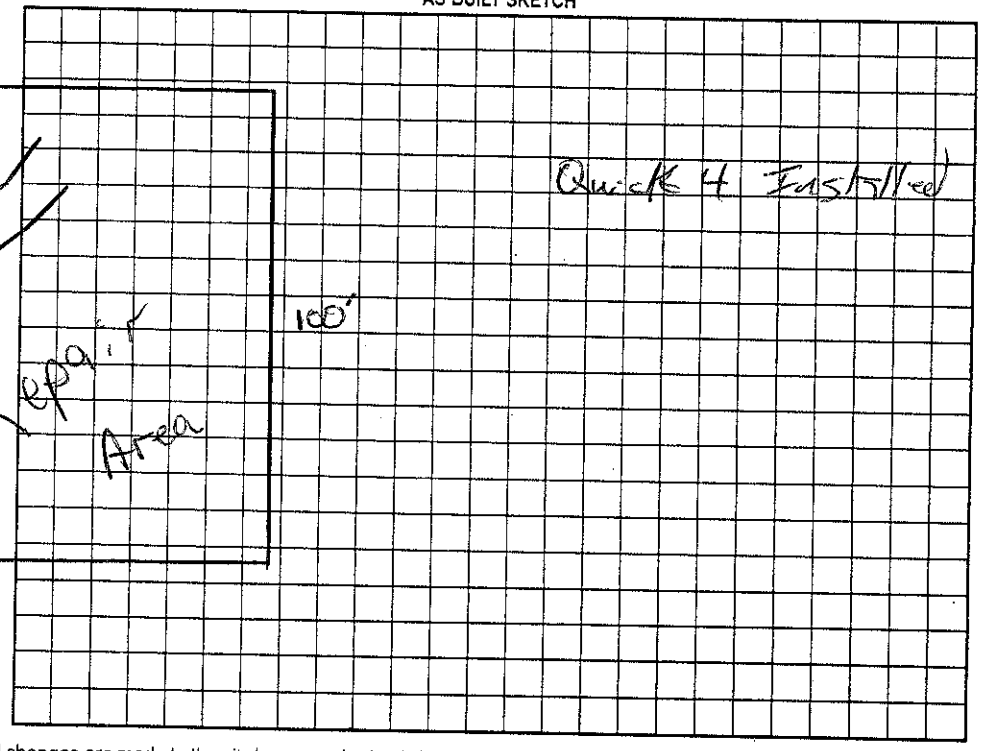

Permit can be suspended or revoked if any false information is supplied toward securing the permit/any unauthorized changes are made to the site/any unauthorized changes are made in the installation of the system. Improvement Permit with plat valid without expiration. Improvement Permit with site plan valid for sixty months. Authorization to Construct is valid for a period equal to that of Improvement Permit – not to exceed sixty months.

Signed: _____ date 2-16-06 Installed by: Corinthian Bldrs

Improvement Permit by: _____ RS date 12/22/05 Operation Permit by: _____ RS date 4/18/06

Authorization to Construct by: _____ date 2-17-06 Existing System Inspection by: _____ date _____

HEALTH DEPT. COPY: WHITE OWNER COPY (FINAL): YELLOW OWNER COPY (INITIAL): PINK