IREDELL COUNTY HEALTH DEPARTMENT

STATESVILLE 704-878-5305 MOORESVILLE 704-664-5281

IMPROVEMENT PERMIT / AUTHORIZATION TO CONSTRUCT / OPERATION PERMIT / EXISTING SYSTEM INSPECTION

PERMIT# 132259 PIN# 9740 41 9017.062 47404 7374 DATE 11/16/05

OWNER OR APPLICANT Christian Bibles PHONE: Business _____ Home _____

ADDRESS Po Box 990 Denver NC 28037

LOCATION 115 N, TL Flowerhouse, TL Carlyle, TR Farmdale, on Rt.

SUBDIVISION Carlyle Farms BLOCK / SECTION _____ LOT 62 LOT AREA 0.505 Ac SITE CLASS. PS DESIGN FLOW 360 L.T.A.R. 0.3

Septic Tank: 1000 Gallons; STB 760 Date 12-13-05
Pump Tank: 1000 Gallons; PT 363 Date _____
Pump Make: Zoeller Model N151 Serial No. _____
Nitrification Field: No Fields 1 Square Feet 900 Linear Feet 300
No Lines 4@75' Trench Width 36" Max Trench Bottom Depth 36" Gravel Depth — Gravity ☒ Pressure

☒ New System ☐ Repair ☐ Expansion System Type: I II III IV V VI
System Description: Pump 25% Reduction
Repair System Description: Same
Maintenance Agreement Required: ☐ Yes ☒ No

☒ House/Mod. Home No. Bedrooms 3
☐ Mobile Home No. Persons _____
☐ Business No. Employees _____
☐ Other _____

Water Supply: ☒ Individual ☐ Public ☐ Community


☐ Slab ☒ Crawl Space ☐ Basement w/plumbing ☐ Basement wo/plumbing

Comments:/Conditions:


1" = 40'

Comments:/Conditions:

INITIAL SITE SKETCH

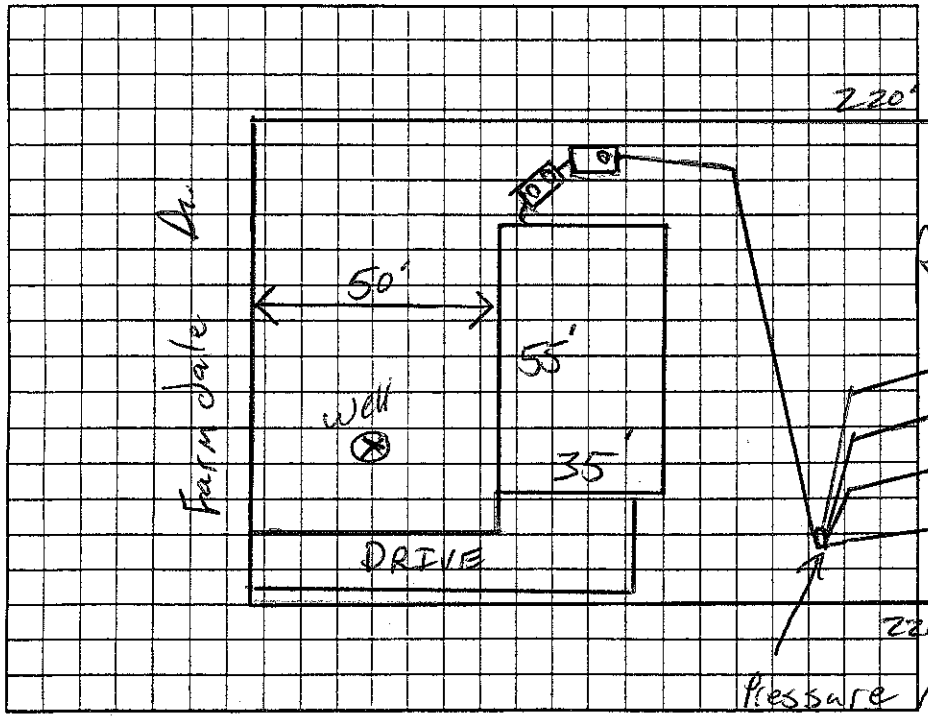

AS BUILT SKETCH

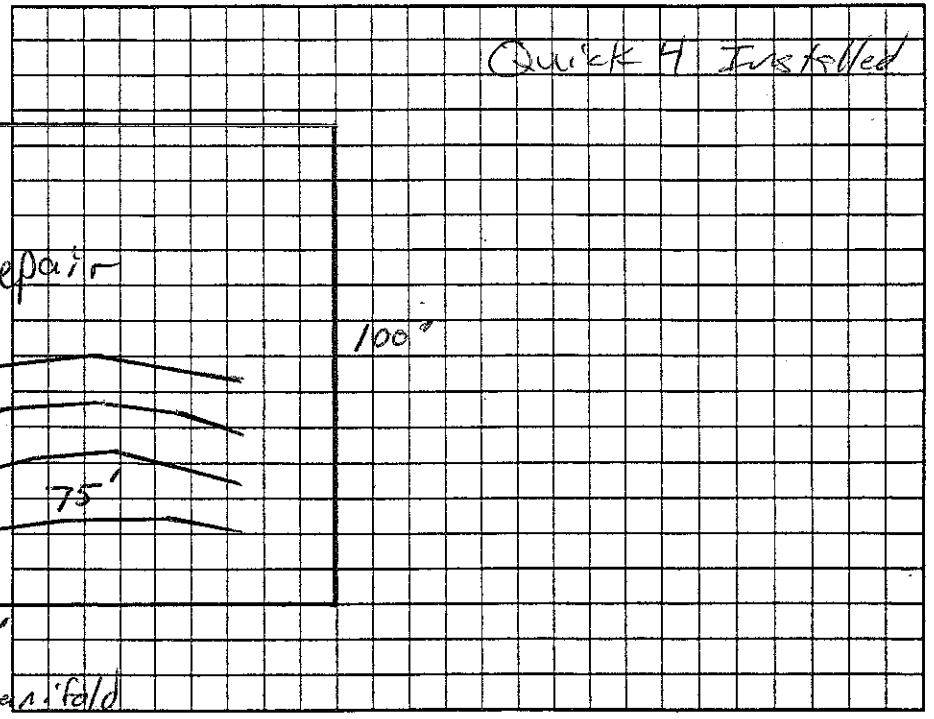

Permit can be suspended or revoked if any false information is supplied toward securing the permit/any unauthorized changes are made to the site/any unauthorized changes are made in the installation of the system. Improvement Permit with plat valid without expiration ☒ Improvement Permit with site plan valid for sixty months ☐ Authorization to Construct is valid for a period equal to that of Improvement Permit – not to exceed sixty months.

Signed: _____ date 11-17-05 Installed by: Abee Grading

Improvement Permit by: _____ RS date 11/16/05 Operation Permit by: _____ RS date 6/1/06

Authorization to Construct by: _____ RS date 11/21/05 Existing System Inspection by: _____ date _____

HEALTH DEPT. COPY: WHITE OWNER COPY (FINAL): YELLOW OWNER COPY (INITIAL): PINK