IREDELL COUNTY HEALTH DEPARTMENT

#775.00 Paid

STATESVILLE 704-878-5305 MOORESVILLE 704-664-5281

IMPROVEMENT PERMIT / AUTHORIZATION TO CONSTRUCT / OPERATION PERMIT / EXISTING SYSTEM INSPECTION

PERMIT# 133039 PIN# 4740417585

OWNER OR APPLICANT Corinthian Builder DATE 12-28-05

ADDRESS P.O. Box 3421 Mooresville PHONE: Business 704-400-1258 Home 704-820-9662

LOCATION Main St. Troutman TR Flower House TR Carlyle TR Farmdale TR Holmfield TR Loram on right

SUBDIVISION Carlyle Farms BLOCK / SECTION ____ LOT 59 LOT AREA .5 Ac SITE CLASS. PS DESIGN FLOW 360gpd L.T.A.R. .3 gpd/ft²

Septic Tank: 1000 Gallons: STB 785 Date 8/1/06

Pump Tank: 1000 Gallons: PT 32 Date 11/27/06

Pump Make: MYERS Model ME-V56-11 Serial No. ____

Nitrification Field: No Fields 1 Square Feet 1200 Linear Feet 300

No Lines 4@75' Trench Width 36" Max Trench Bottom Depth 36" Gravel Depth NA ☐ Gravity ☒ Pressure

☑ New System ☐ Repair ☐ Expansion System Type: I II III IV V VI

System Description: 25% Reduction pm

Repair System Description: LP Panel

Maintenance Agreement Required: ☐ Yes ☒ No

☒ House/Mod. Home No. Bedrooms 3

☐ Mobile Home No. Persons ____

☐ Business No. Employees ____

☐ Other ____

Water Supply: ☒ Individual ☐ Public ☐ Community

☐ Slab ☒ Crawl Space ☐ Basement w/plumbing ☐ Basement wo/plumbing

Comments:/Conditions:

Comments:/Conditions:

INITIAL SITE SKETCH

System Layout as per SY EC East Track Sketch Map

AS BUILT SKETCH

Permit can be suspended or revoked if any false information is supplied toward securing the permit/any unauthorized changes are made to the site/any unauthorized changes are made in the installation of the system. Improvement Permit with plat valid without expiration ☑ Improvement Permit with site plan valid for sixty months ☐ Authorization to Construct is valid for a period equal to that of Improvement Permit – not to exceed sixty months.

Signed: ____ date ____

Improvement Permit by: ____ date 12-28-05

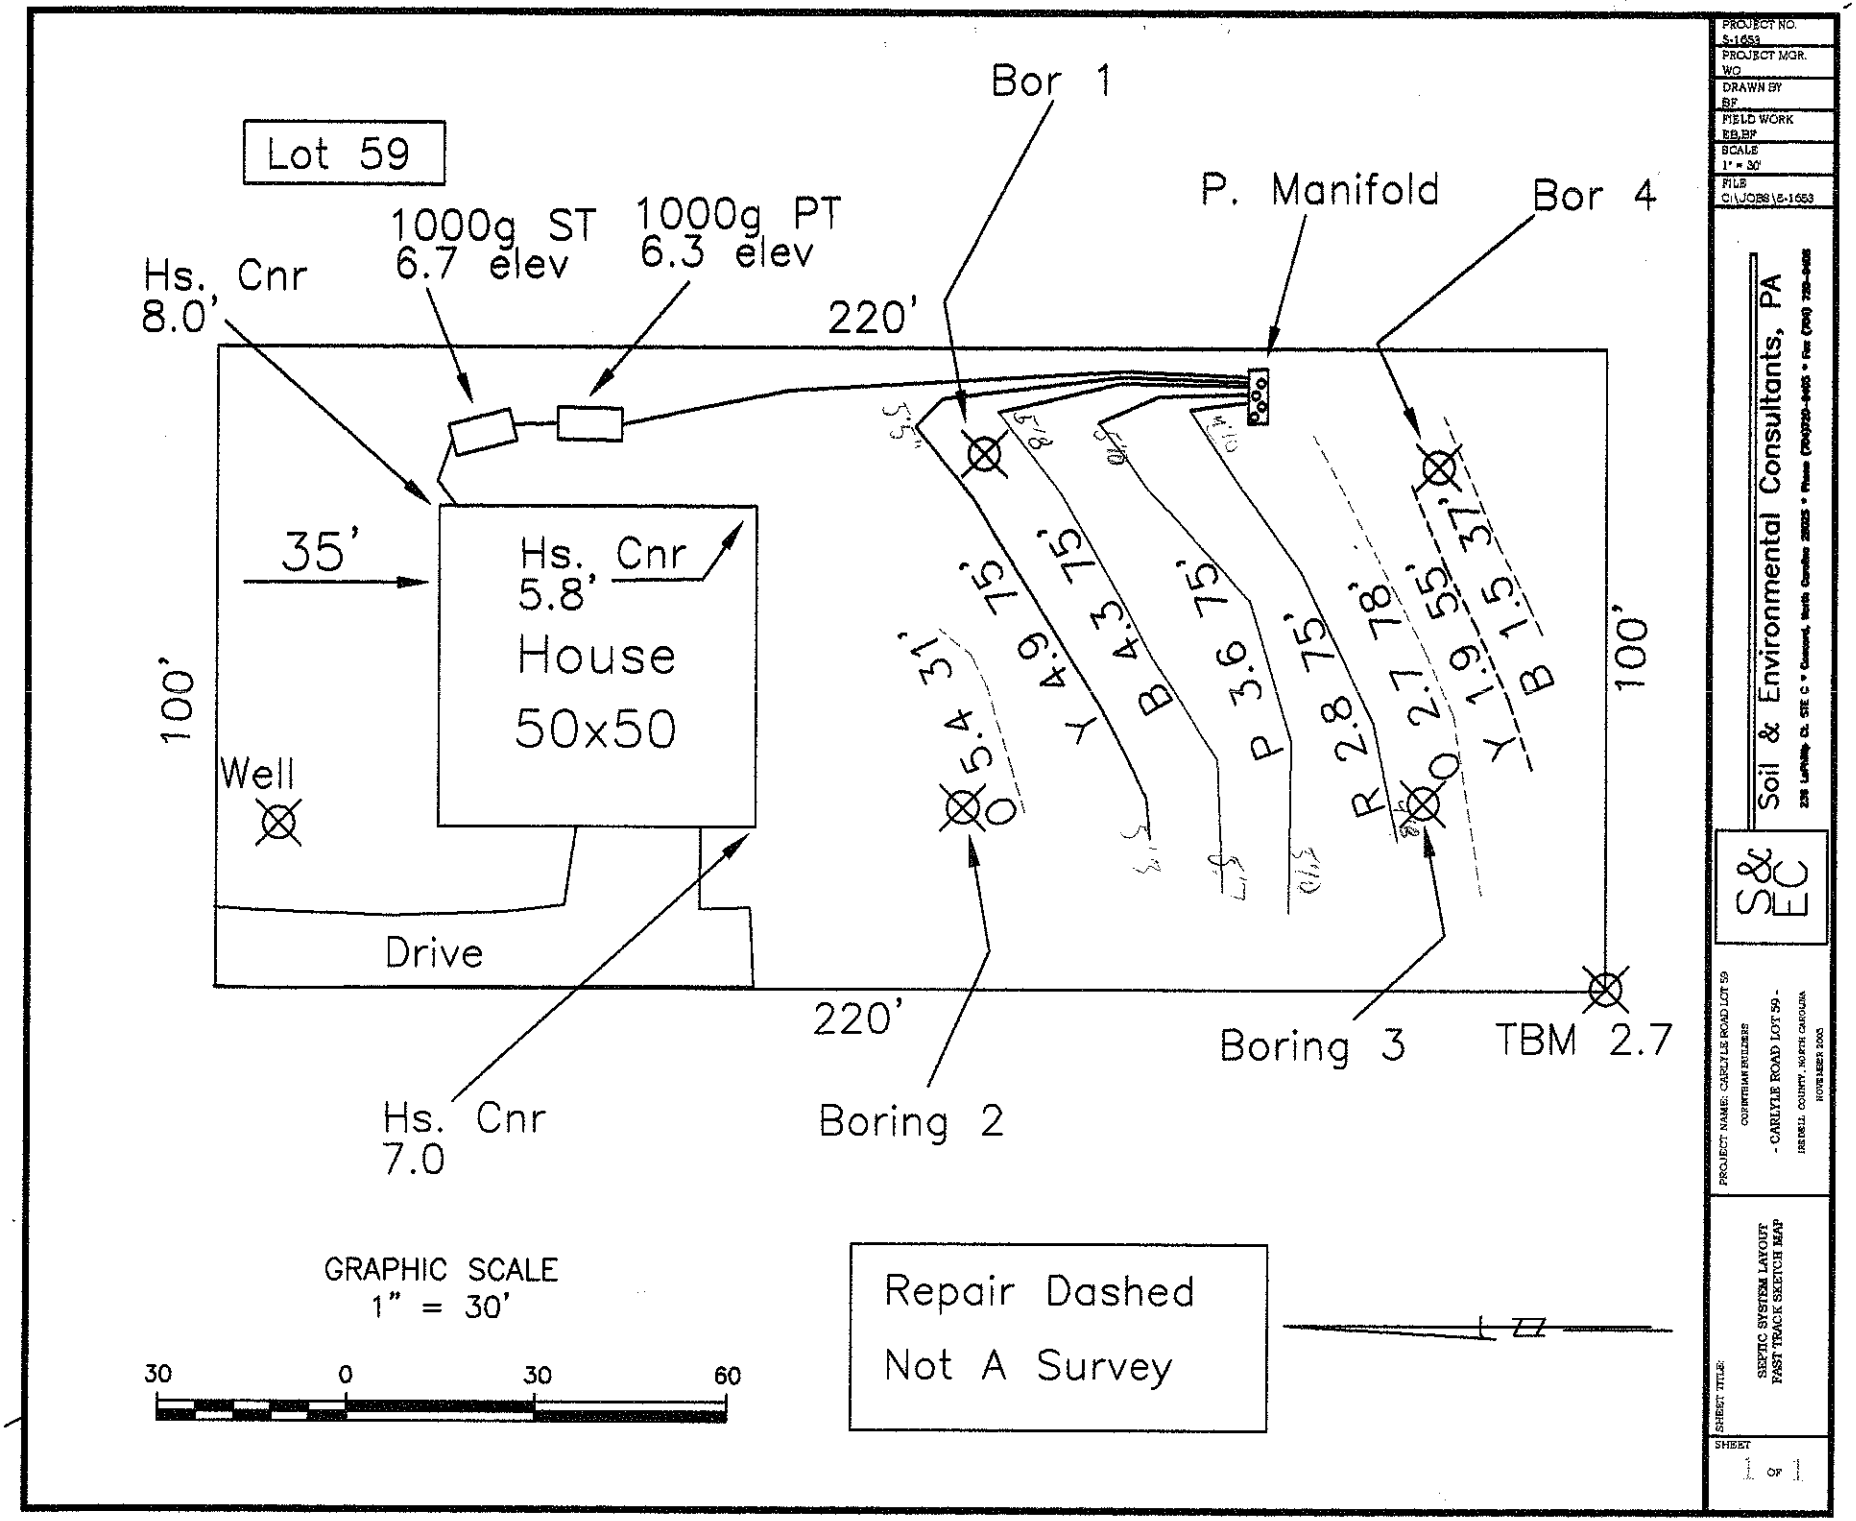
Authorization to Construct by: ____ date 3-1-06

Installed by: Corinthian

Operation Permit by: ____ date 4/12/06

Existing System Inspection by: ____ date ____

HEALTH DEPT. COPY: WHITE OWNER COPY (FINAL): YELLOW OWNER COPY (INITIAL): PINK


Lot 59
Bor 1
P. Manifold
Bor 4
1000g ST
6.7 elev
1000g PT
6.3 elev
Hs., Cnr
8.0'
220'
35'
Hs., Cnr
5.8'
House
50x50
100'
100'
Well
Drive
220'
Hs. Cnr
7.0
Boring 2
Boring 3
TBM 2.7
GRAPHIC SCALE
1" = 30'
30
0
30
60
Repair Dashed
Not A Survey
PROJECT NO.
S-1653
PROJECT MGR.
WO
DRAWN BY
BF
FIELD WORK
EB,BF
SCALE
1" = 30'
FILE
C:\JOBS\S-1653
Soil & Environmental Consultants, PA
S&EC
PROJECT NAME: CARLYLE ROAD LOT 59
- CARLYLE ROAD LOT 59 -
IREDELL COUNTY, NORTH CAROLINA
NOVEMBER 2005
SHEET TITLE:
SEPTIC SYSTEM LAYOUT
FAST TRACK SKETCH MAP
SHEET
1 OF 1