IREDELL COUNTY HEALTH DEPARTMENT

STATESVILLE 704-878-5305 MOORESVILLE 704-664-5281

IMPROVEMENT PERMIT / AUTHORIZATION TO CONSTRUCT / OPERATION PERMIT / EXISTING SYSTEM INSPECTION

PERMIT# 134180 PIN# 4740 41 8362 DATE 3/21/06

OWNER OR APPLICANT Courthian Builders PHONE: Business 704-820-9662 Home

ADDRESS PO Box 3241 Mooresville, NC 28117

LOCATION 115-21N TL 1st Flower House LP, TL Carlyle Rd TR Farmdale 1st Lot on (R) After Grafton Pl.

SUBDIVISION Carlyle Farms BLOCK / SECTION LOT 63 LOT AREA .504 SITE CLASS. PS DESIGN FLOW 360 L.T.A.R. .3

Septic Tank: 1000 Gallons; STB 736 Date

Pump Tank: 1000 Gallons; PT 40 Date

Pump Make: Myers Model ME50 Serial No.

Nitrification Field: No Fields 1 Square Feet 900 Linear Feet 300

No Lines 3@100 Trench Width 3 Max Trench Bottom Depth 3' Gravel Depth No

☒ New System ☐ Repair ☐ Expansion System Type: I II (III) IV V VI

System Description: PM → 25% Reduced

Repair System Description: Pressed 16' PPBPS

Maintenance Agreement Required: ☐ Yes ☒ No

☒ House/Mod. Home ☐ Mobile Home ☐ Business ☐ Other

No. Bedrooms 3 No. Persons 2 No. Employees


Water Supply: ☒ Individual ☐ Public ☐ Community

☐ Gravity ☒ Pressure ☐ Slab ☒ Crawl Space ☐ Basement w/plumbing ☐ Basement wo/plumbing

Comments:/Conditions:

Comments:/Conditions:

INITIAL SITE SKETCH

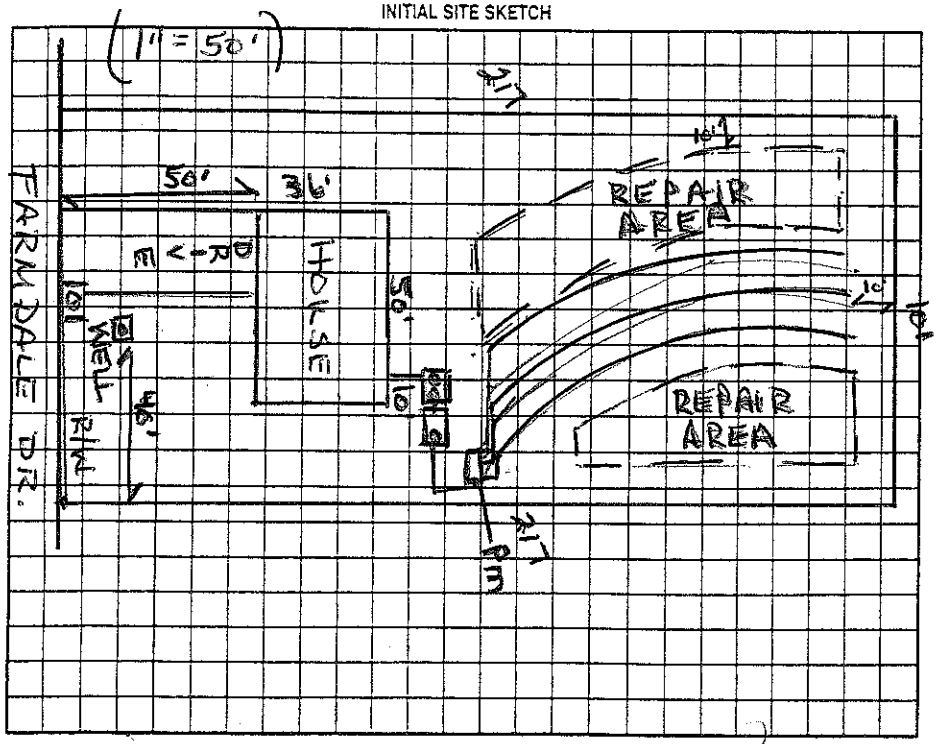

AS BUILT SKETCH

Quick 4 Installed

Permit can be suspended or revoked if any false information is supplied toward securing the permit/any unauthorized changes are made to the site/any unauthorized changes are made in the installation of the system. Improvement Permit with plat valid without expiration. ☐ Improvement Permit with site plan valid for sixty months ☐ Authorization to Construct is valid for a period equal to that of Improvement Permit – not to exceed sixty months.

Signed: X date 5-4-3

Improvement Permit by: Wesley Sparks RS. date 3/21/06

Authorization to Construct by: Wesley Sparks RS. date 3/21/06

Installed by: Courthian Bldr.

Operation Permit by: RS date 8/29/06

Existing System Inspection by: date

HEALTH DEPT. COPY: WHITE OWNER COPY (FINAL): YELLOW OWNER COPY (INITIAL): PINK