IREDELL COUNTY HEALTH DEPARTMENT

STATESVILLE 704-878-5305 MOORESVILLE 704-664-5281

IMPROVEMENT PERMIT / AUTHORIZATION TO CONSTRUCT / OPERATION PERMIT / EXISTING SYSTEM INSPECTION

PERMIT# 133038 PIN# 4740418596 DATE 12-28-05

OWNER OR APPLICANT Corinthian Builders Ltd PHONE: Business 704-400-1258 Home 704-820-9662

ADDRESS PO Box 3421 Mooresville

LOCATION main st Troutman TR Flower House TR Carlyle TR Farmdale TR Holmfield TR Loram on right

SUBDIVISION Carlyle Farms BLOCK / SECTION 3 LOT 58 LOT AREA .5 Ac SITE CLASS. PS DESIGN FLOW 360 gpd L.T.A.R. .3 gpd/ft²

Septic Tank: 1000 Gallons; STB 786 Date

Pump Tank: 1000 Gallons; PT 32 Date

Pump Make: ~~Goulds~~ Myers Model WE05011 H Serial No.

Nitrification Field: No Fields 1 Square Feet 1200 Linear Feet 300

No Lines 4@75' Trench Width 36" Max Trench Bottom Depth 24" Gravel Depth NA ☐ Gravity ☒ Pressure

☒ New System ☐ Repair ☐ Expansion System Type: I II III IV V VI

System Description: 25% reduction pm

Repair System Description: LP Panel

Maintenance Agreement Required: ☐ Yes ☒ No

☒ House/Mod. Home No. Bedrooms 3

☐ Mobile Home No. Persons

☐ Business No. Employees

☐ Other

Water Supply: ☒ Individual ☐ Public ☐ Community

☐ Slab ☒ Crawl Space ☐ Basement w/plumbing ☐ Basement wo/plumbing

Comments:/Conditions:

Comments:/Conditions:

INITIAL SITE SKETCH

System Layout as per S&EC Fast Track Sketch Map

AS BUILT SKETCH


Permit can be suspended or revoked if any false information is supplied toward securing the permit/any unauthorized changes are made to the site/any unauthorized changes are made in the installation of the system. Improvement Permit with plat valid without expiration ☑ Improvement Permit with site plan valid for sixty months ☐ Authorization to Construct is valid for a period equal to that of Improvement Permit – not to exceed sixty months.

Signed: [signature] date 1-24-06 Installed by: Corinthian

Improvement Permit by: [signature] date 12-28-05 Operation Permit by: [signature] RS date 4/28/06

Authorization to Construct by: [signature] RS date 1/25/06 Existing System Inspection by: date

HEALTH DEPT. COPY: WHITE OWNER COPY (FINAL): YELLOW OWNER COPY (INITIAL): PINK

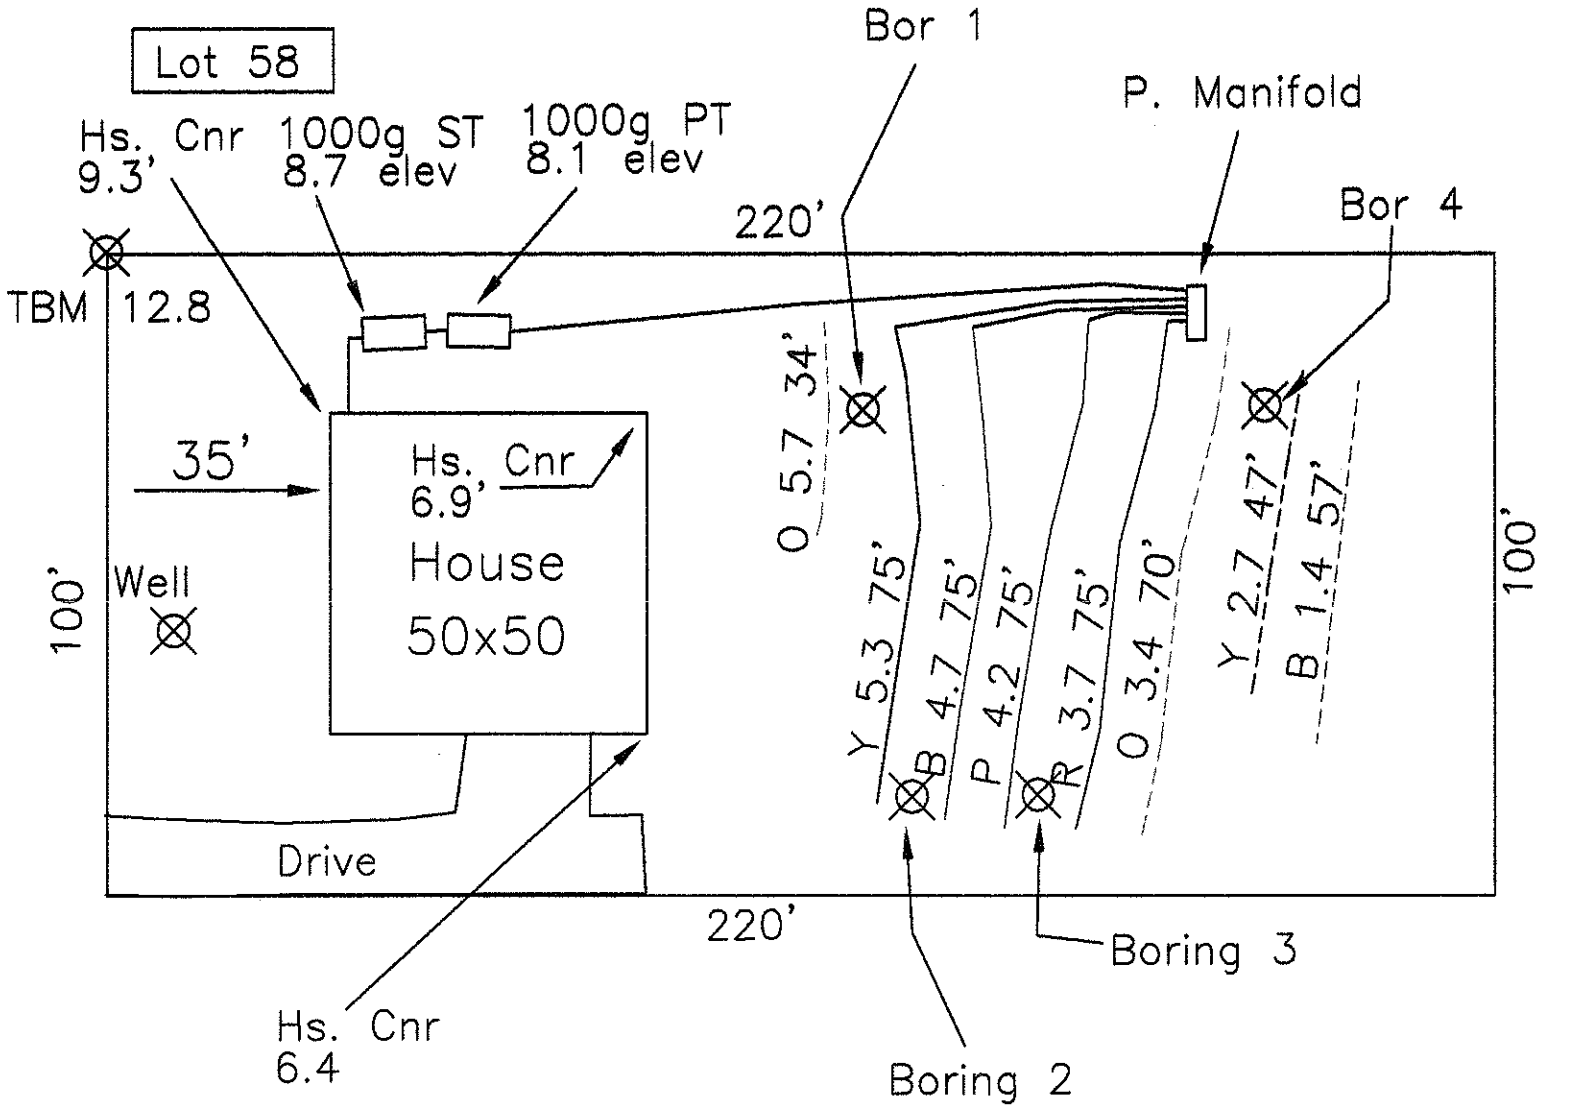

GRAPHIC SCALE
1" = 30'

30 0 30 60

Repair Dashed
Not A Survey

PROJECT NO. S-1653
PROJECT MGR. WO
DRAWN BY BF
FIELD WORK BB,BF
SCALE 1" = 30'
FILE C:\JOBS\S-1653

Soil & Environmental Consultants, PA
259 Lafferty Ct. STE C • Concord, North Carolina 28025 • Phone (704)720-8405 • Fax (704) 720-8406

S&EC

PROJECT NAME: CARLYLE ROAD LOT 58
CHRISTIAN BUILDERS
- CARLYLE ROAD LOT 58 -
IREDELL COUNTY, NORTH CAROLINA
NOVEMBER 2005

SHEET TITLE:
SEPTIC SYSTEM LAYOUT
FAST TRACK SKETCH MAP

SHEET
1 OF 1