IREDELL COUNTY HEALTH DEPARTMENT

STATESVILLE 704-878-5305 MOORESVILLE 704-664-5281

IMPROVEMENT PERMIT / AUTHORIZATION TO CONSTRUCT / OPERATION PERMIT / EXISTING SYSTEM INSPECTION

PERMIT# 35587 PIN# 4740 41 8900 DATE 5/9/06

OWNER OR APPLICANT Corinthian Bldrs, PHONE: Business Home

ADDRESS PO Box 990 Denver NC 28037

LOCATION 115 N, TL Flowerhouse, TL Carlyle, TR Escondale, TR Holmfield, TR Loram, on Lt

SUBDIVISION Carlyle Farm BLOCK / SECTION B LOT 46 LOT AREA 0.787ac SITE CLASS. PS DESIGN FLOW 360 L.T.A.R. 0.3

Septic Tank: 1600 Gallons: STB 744 Date 4/19/06

Pump Tank: Gallons: PT Date

Pump Make: Model Serial No.

Nitrification Field: No Fields 1 Square Feet 900 Linear Feet 300

No Lines 4@75' Trench Width 36" Max Trench Bottom Depth 36" Gravel Depth —

[X] New System ☐ Repair ☐ Expansion System Type: I II III IV V VI

System Description: 25% Reduction

Repair System Description: Same

Maintenance Agreement Required: ☐ Yes [X] No

[X] Gravity ☐ Pressure

[X] House/Mod. Home ☐ Mobile Home ☐ Business ☐ Other

No. Bedrooms 3 No. Persons No. Employees

Water Supply: [X] Individual ☐ Public ☐ Community


☐ Slab [X] Crawl Space ☐ Basement w/plumbing ☐ Basement wo/plumbing

Comments:/Conditions:


1"=50'

Comments:/Conditions:

INITIAL SITE SKETCH

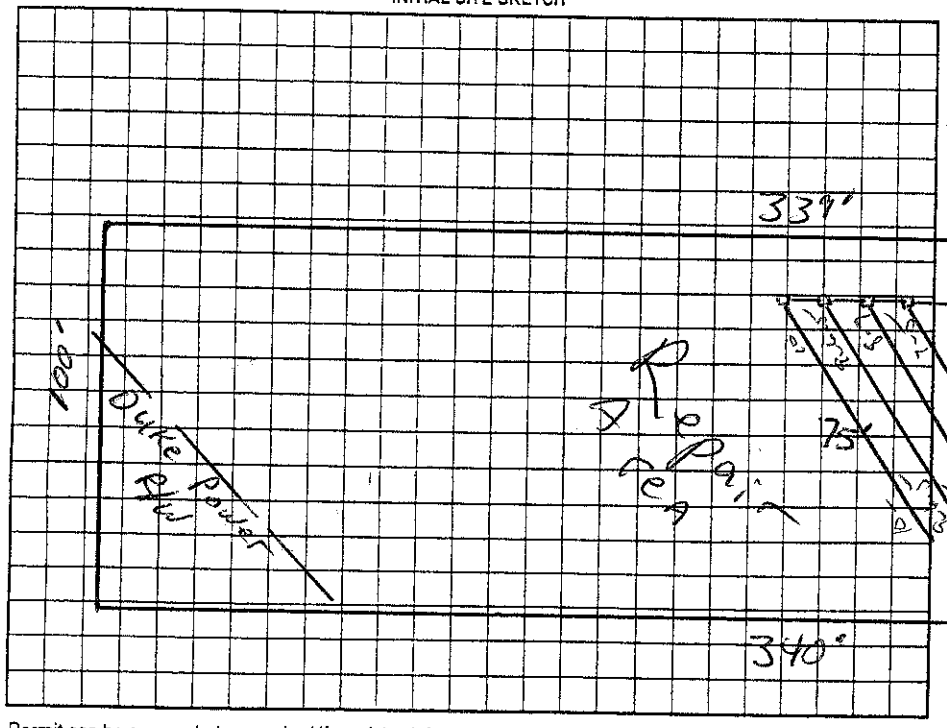

AS BUILT SKETCH

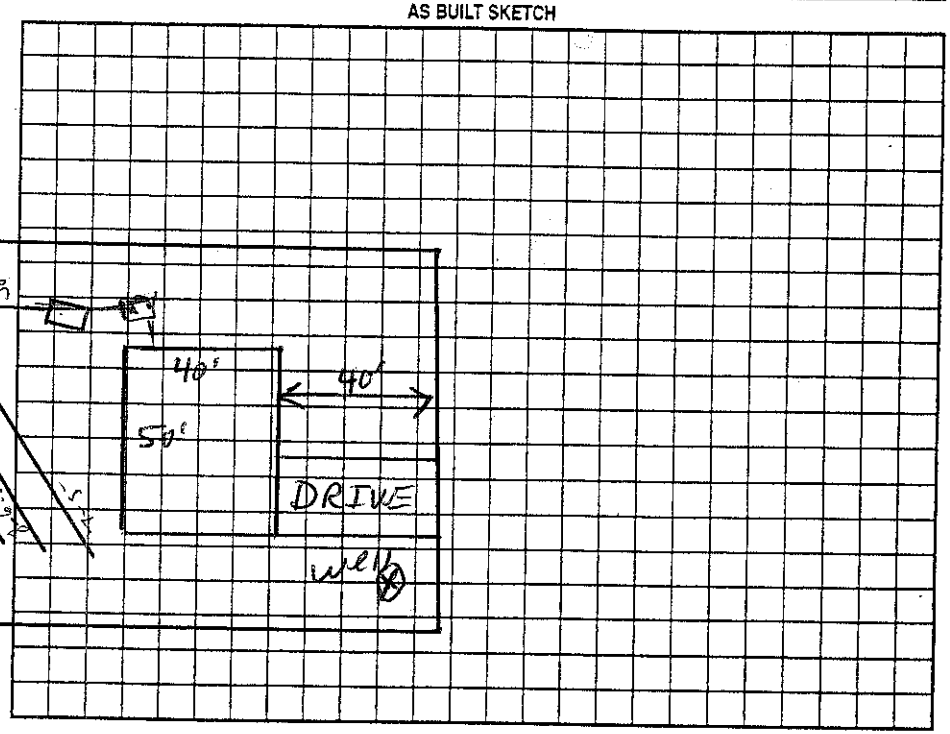

Permit can be suspended or revoked if any false information is supplied toward securing the permit/any unauthorized changes are made to the site/any unauthorized changes are made in the installation of the system. Improvement Permit with plat valid without expiration. ☐ Improvement Permit with site plan valid for sixty months [X] Authorization to Construct is valid for a period equal to that of Improvement Permit – not to exceed sixty months.

Signed: date 5-10-06

Improvement Permit by: RS date 5/9/06

Authorization to Construct by: RS date 5/9/06

Installed by: Corinthian Development

Operation Permit by: Wesley Sparks RS date 10/11/06

Existing System Inspection by: date

HEALTH DEPT. COPY: WHITE OWNER COPY (FINAL): YELLOW OWNER COPY (INITIAL): PINK