Formerly lot #26 & #28

IREDELL COUNTY HEALTH DEPARTMENT

STATESVILLE 704-878-5305 MOORESVILLE 704-664-5281

IMPROVEMENT PERMIT / AUTHORIZATION TO CONSTRUCT / OPERATION PERMIT / EXISTING SYSTEM INSPECTION

PERMIT# 086473 PIN# ~~4740328058 PT~~ 4740-42-7934 DATE 11/16/99

OWNER OR CONTRACTOR Spears Construction PHONE: Business 361-7518 Home

ADDRESS 607 Anderson Salisbury, NC 28144

LOCATION Perth Rd TR Clontz Hill TR into Forest Glen at intersection on right.

SUBDIVISION Forest Glen BLOCK / SECTION 2 LOT 1 LOT AREA .65 Acre SITE CLASS. PS DESIGN FLOW 360 gpd L.T.A.R. .3

Septic Tank: 1000 Gallons; STB 825 Date 1/2/00
Pump Tank: Gallons; PT Date
Pump Make: Model Serial No.
Nitrification Field: No Fields 1 Square Feet 900' Linear Feet 300'
No Lines 4@75' Trench Width 36" Max Trench Bottom Depth 36"

[X] New System [ ] Repair System Type: I, II, (III), IV, V, VI
System Description: Gravity - 25% Reduction
Repair System Description: Gravity - Modified
Maintenance Agreement Required: [ ] Yes [X] No


[X] House/Mod. Home No. Bedrooms 3
[ ] Mobile Home No. Bathrooms 2
[ ] Business No. Employees
[ ] Other
Gravel Depth N/A [X] Slab [ ] Crawl Space [ ] Basement w/plumbing [ ] Basement wo/plumbing

Water Supply: [X] Individual [ ] Public [ ] Community


Comments:/Conditions: Keep Septic System at least 10' from PL, 5' from house & 50-100' from well.

Comments:/Conditions:

INITIAL SITE SKETCH Scale 1:50

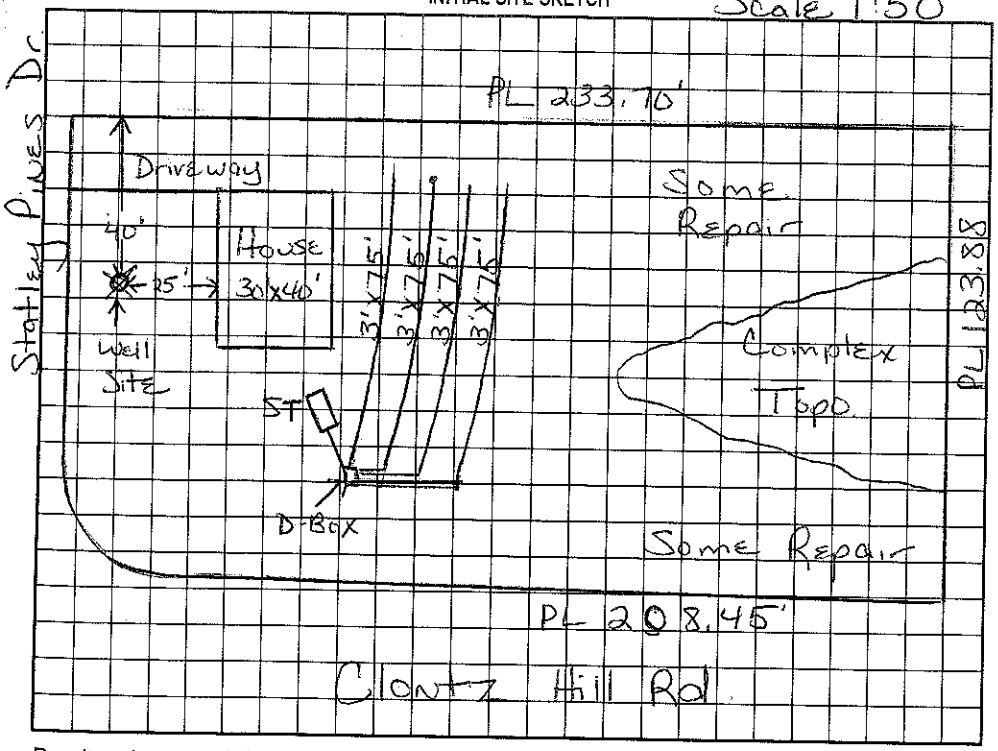

AS BUILT SKETCH

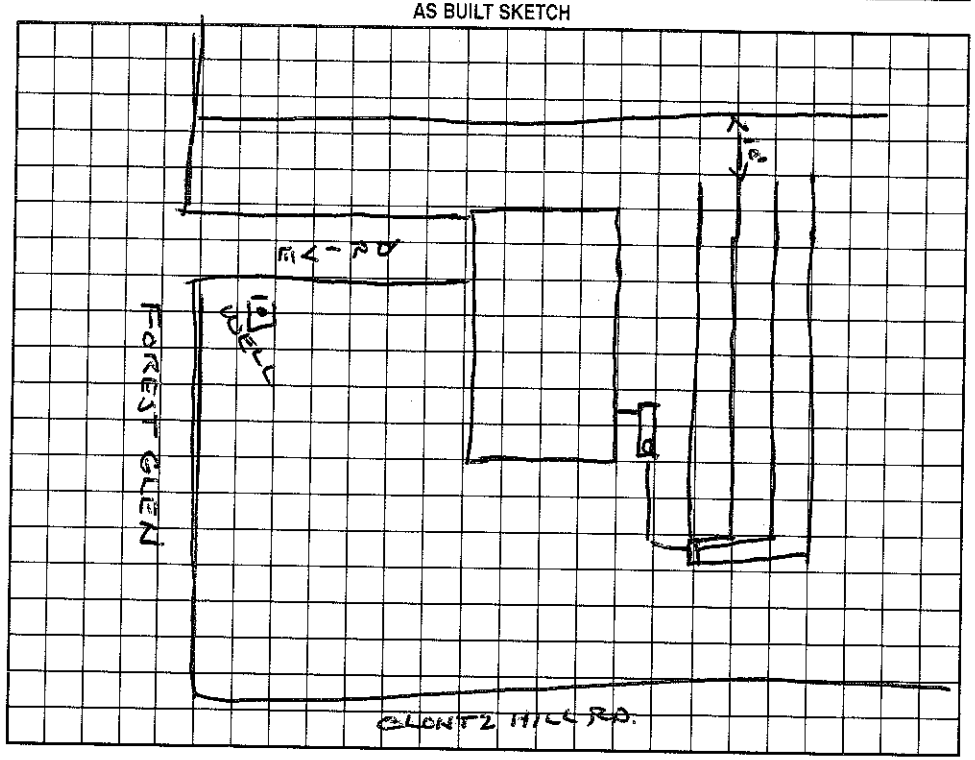

Permit can be suspended or revoked if any false information is supplied toward securing the permit/any unauthorized changes are made to the site/any unauthorized changes are made in the installation of the system. Improvement Permit with plat valid without expiration. Improvement Permit with site plan valid for sixty months. Authorization to Construct is valid for a period equal to that of Improvement Permit – not to exceed sixty months.

Signed: date 1/3/00
Improvement Permit by: Maria H. Dotson date 11/16/99
Authorization to Construct by: Maria H. Dotson date 11/16/99

Installed by: Rowan Septic Tank
Operation Permit by: Wesley Sparks date 2/17/00
Existing System Inspection by: date

HEALTH DEPT. COPY: WHITE OWNER COPY (FINAL): YELLOW OWNER COPY (INITIAL): PINK