IREDELL COUNTY HEALTH DEPARTMENT

Paid 125.00 PT

STATESVILLE 704-878-5305 MOORESVILLE 704-664-5281

IMPROVEMENT PERMIT / AUTHORIZATION TO CONSTRUCT / OPERATION PERMIT / EXISTING SYSTEM INSPECTION

PERMIT# 086485 PIN# ~~4744032805 8PT~~ 4740-42-9666 DATE 4-10-2000

OWNER OR CONTRACTOR Max Spears Construction PHONE: Business (704) 636 7954 Home

ADDRESS 607 Anderson Ave Salisbury, NC 28144

LOCATION Hwy 115 N. TL Flowerhouse Rd Glontz Hill TL Stately Pines at intersection w/Misty Sprgs.

SUBDIVISION Forest Glen BLOCK / SECTION LOT 12 LOT AREA .5 Acre SITE CLASS. PS DESIGN FLOW 360gpd L.T.A.R. .3

Septic Tank: 1000 Gallons; STB 825 Date 4/4/00

Pump Tank: Gallons; PT Date

Pump Make: Model Serial No.

Nitrification Field: No Fields 1 Square Feet 900' Linear Feet 300'

No Lines 4 Trench Width 36" Max Trench Bottom Depth 36" Gravel Depth

☒ New System ☐ Repair System Type: I, II, III, IV, V, VI

System Description: Gravity – 25% Reduction

Repair System Description: Gravity – Innovative

Maintenance Agreement Required: ☒ Yes ☐ No

☒ House/Mod. Home No. Bedrooms 3

☐ Mobile Home No. Bathrooms 2

☐ Business No. Employees

☐ Other


☐ Slab ☐ Crawl Space ☐ Basement w/plumbing ☐ Basement wo/plumbing

Water Supply:
☒ Individual
☐ Public
☐ Community

Comments:/Conditions: Keep Septic System 10' From PL, 5' From House & 50'+ From Well

Comments:/Conditions: ☆ 25% Reduction in Drainfield area – with bending Contours. Installer may Need to use "E-Z Lay" Drainfield.

INITIAL SITE SKETCH Scale 1:50

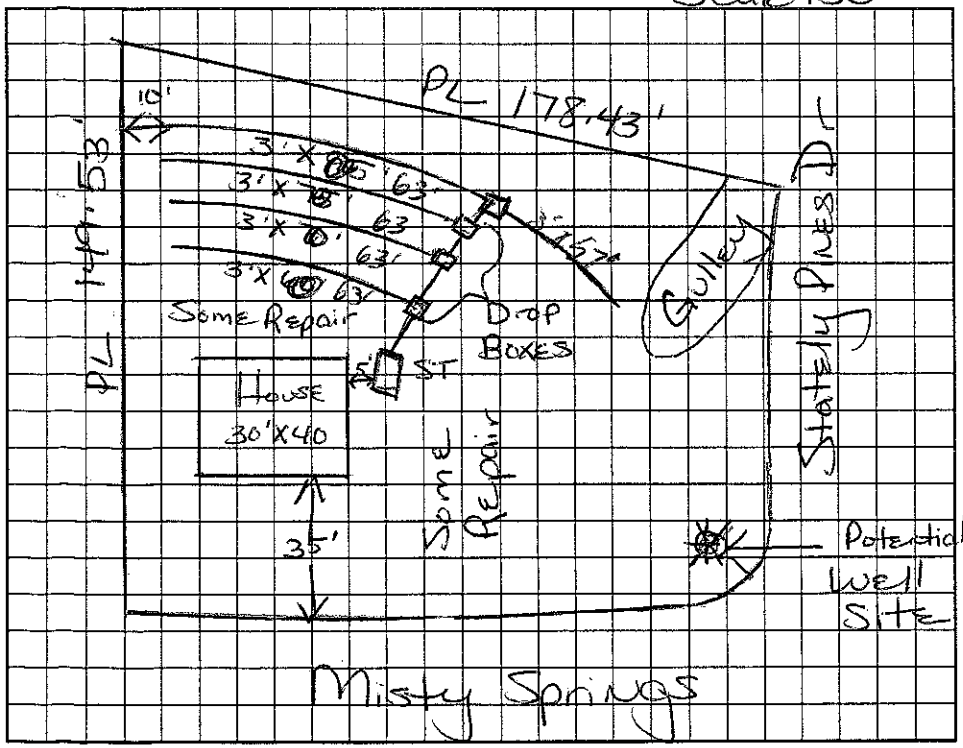

AS BUILT SKETCH

Permit can be suspended or revoked if any false information is supplied toward securing the permit/any unauthorized changes are made to the site/any unauthorized changes are made in the installation of the system. Improvement Permit with plat valid without expiration. Improvement Permit with site plan valid for sixty months. Authorization to Construct is valid for a period equal to that of Improvement Permit – not to exceed sixty months.

Signed: date 4/12/00 Installed by: Rowan Septic

Improvement Permit by: Maria H. Dotson RS date 4/10/2000 Operation Permit by: RS date 6/1/00

Authorization to Construct by: Maria H. Dotson RS date 4/10/2000 Existing System Inspection by: date

HEALTH DEPT. COPY: WHITE OWNER COPY (FINAL): YELLOW OWNER COPY (INITIAL): PINK