IREDELL COUNTY HEALTH DEPARTMENT

STATESVILLE 704-878-5305 MOORESVILLE 704-664-5281

IMPROVEMENT PERMIT / AUTHORIZATION TO CONSTRUCT / OPERATION PERMIT / EXISTING SYSTEM INSPECTION

PERMIT# 074785 PIN# ~~4740 43 9677~~ 4740 43 8574 DATE 7/27/98

OWNER OR CONTRACTOR Richard L. Horton PHONE: Business 528-0255 Home

ADDRESS 119 Pinecroft Ct. Troutman, NC. 28166

LOCATION Perth Rd TR Clontz Hill Rd. approximately 2 miles on (L)

SUBDIVISION BLOCK / SECTION LOT N/A LOT AREA ~5Ac SITE CLASS. PS DESIGN FLOW 360 L.T.A.R. .3

Septic Tank: 1000 Gallons; STB 797 Date 11/4/99
Pump Tank: Gallons; PT Date
Pump Make: Model Serial No.
Nitrification Field: No Fields 1 Square Feet 1200 Linear Feet 400
No Lines 3 Trench Width 36" Max Trench Bottom Depth 36" Gravel Depth 12"

[X] New System ☐ Repair System Type: I, (II), III, IV, V, VI
System Description: Gravity Conventional
Repair System Description: Same
Maintenance Agreement Required: ☐ Yes [X] No

[X] House/Mod. Home No. Bedrooms 3
☐ Mobile Home No. Bathrooms 2
☐ Business No. Employees
☐ Other
☐ Slab ☐ Crawl Space [X] Basement w/plumbing ☐ Basement wo/plumbing


Water Supply: [X] Individual ☐ Public ☐ Community

Comments:/Conditions:


Comments:/Conditions:

1155'

INITIAL SITE SKETCH

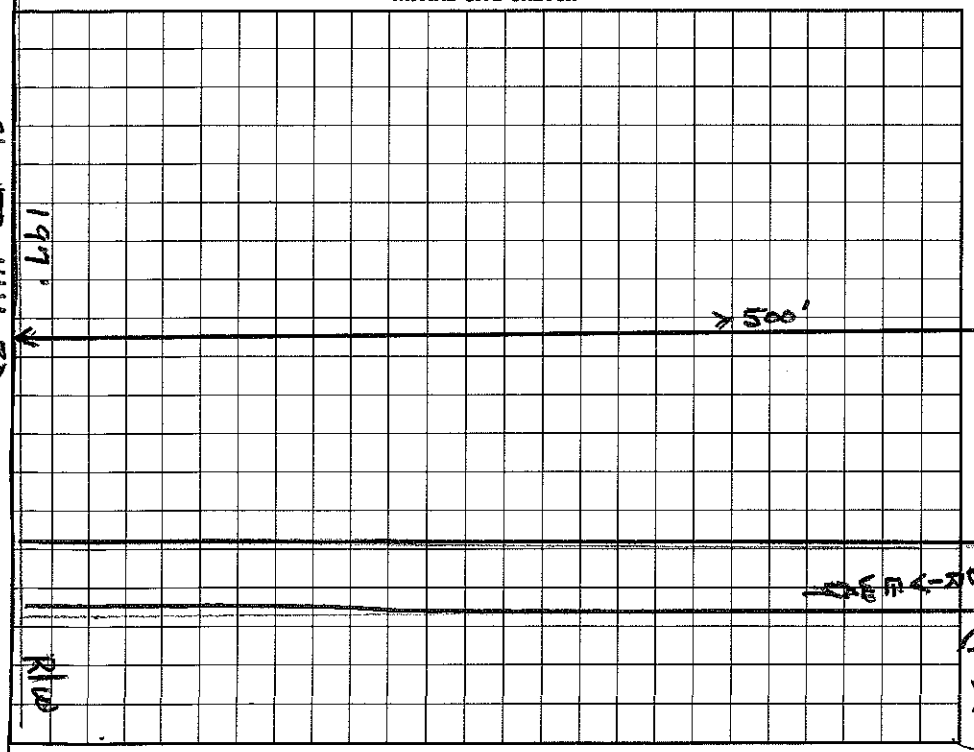

AS BUILT SKETCH

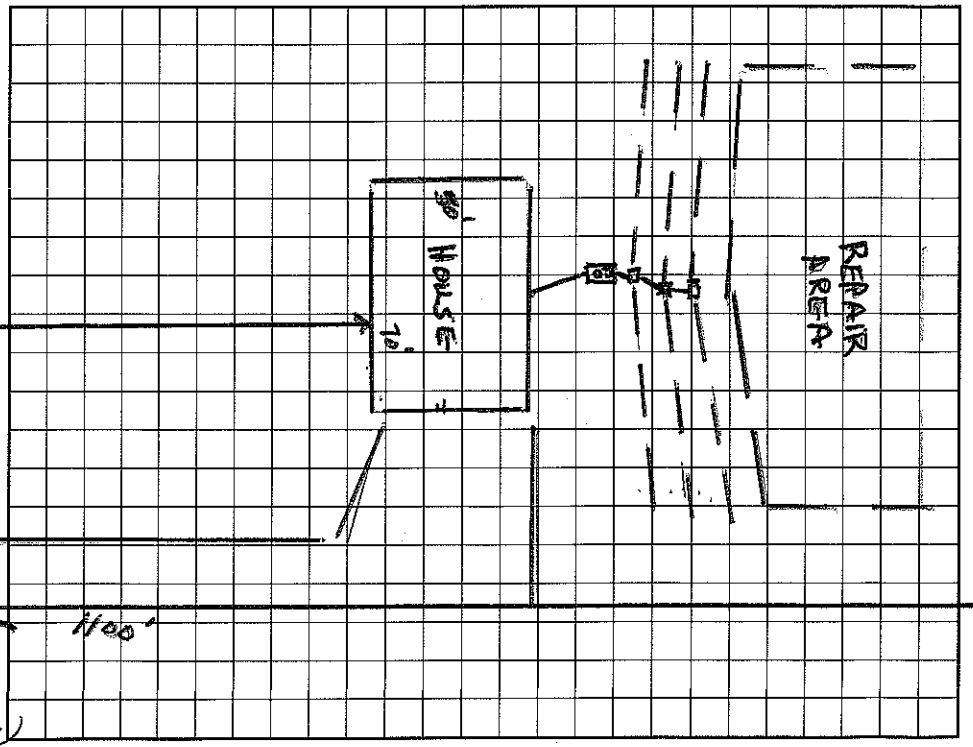

I understand that this permit can be suspended or revoked if any false information is supplied toward securing the permit/any unauthorized changes are made to the site/any unauthorized changes are made in the installation of the system. Improvement Permit with plat valid without expiration. Improvement Permit with site plan valid for sixty months. Authorization to Construct is valid for a period equal to that of Improvement Permit – not to exceed sixty months.

Signed: * Thomas J. Horton date 8/17/98

Improvement Permit by: Wesley Sparks R.S. date 7/27/98

Authorization to Construct by: Wesley Sparks R.S. date 7/27/98

Installed by: Curt Dunning

Operation Permit by: Wesley Sparks R.S. date 11/17/99

Existing System Inspection by: date

HEALTH DEPT. COPY: WHITE INSPECTION COPY (FINAL): GREEN OWNER COPY (FINAL): YELLOW INSPECTION COPY (INITIAL): PINK OWNER COPY (INITIAL): GOLD