IREDELL COUNTY HEALTH DEPARTMENT

STATESVILLE 704-878-5305 MOORESVILLE 704-664-5281

IMPROVEMENT PERMIT / AUTHORIZATION TO CONSTRUCT / OPERATION PERMIT / EXISTING SYSTEM INSPECTION

PERMIT# REPAIR PIN# 4740-48-7105 DATE 12-1-09

OWNER OR APPLICANT JIMMY MILSAPPS PHONE: Business 704-929-6610 Home

ADDRESS 228 BARKDALE RD, TROUTMAN NC

LOCATION

SUBDIVISION — BLOCK / SECTION — LOT — LOT AREA 4.22 AC SITE CLASS DESIGN FLOW 360GPD TAR .3

Septic Tank: 1000 Gallons: STB 1007 Date 9-30-09

Pump Tank: Gallons: PT Date

Pump Make: Model Serial No.

Nitrification Field: No Fields 1 Square Feet Linear Feet 300'

No Lines 3@100' Trench Width 36" Max Trench Bottom Depth 36"

☒ New System ☒ Repair ☐ Expansion System Type: I (II) III IV V VI

System Description: GRAVITY 25% REDUCTION

Repair System Description: SAME

Maintenance Agreement Required: ☐ Yes ☒ No

☒ House/Mod. Home No. Bedrooms 3

☐ Mobile Home No. Persons

☐ Business No. Employees

☐ Other


Water Supply: ☒ Individual ☐ Public ☐ Community

Gravel Depth — ☒ Gravity ☐ Pressure ☐ Slab ☒ Crawl Space ☐ Basement w/plumbing ☐ Basement wo/plumbing

Comments:/Conditions: 1) PUMP + FILL OLD TANK 2) DRAIN LINES MUST BE 250' FROM WELL 3) IF CHAMBERS ARE USED, END CAPS CAN BE USED INSTEAD OF DROP BOXES

Comments:/Conditions:

INITIAL SITE SKETCH

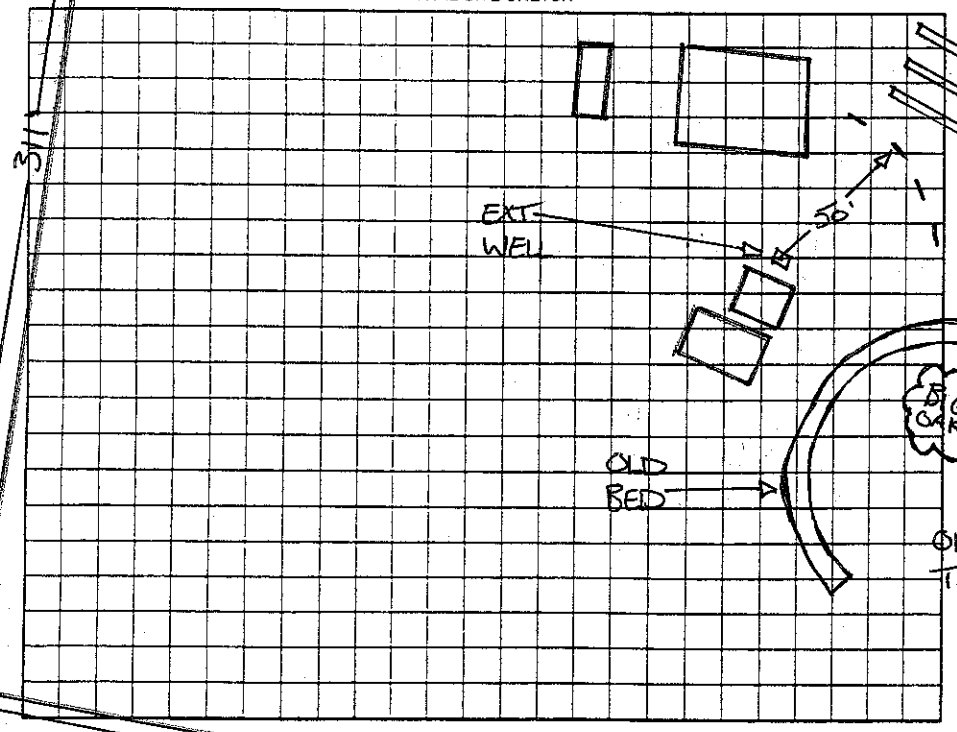

1"=60'

AS BUILT SKETCH

Permit can be suspended or revoked if any false information is supplied toward securing the permit/any unauthorized changes are made to the site/any unauthorized changes are made in the installation of the system. Improvement Permit with plat valid without expiration ☐ Improvement Permit with site plan valid for sixty months ☒ Authorization to Construct is valid for a period equal to that of Improvement Permit – not to exceed sixty months.

Signed: date 12-01-09 Installed by: BOWLS

Improvement Permit by: REHS date 12-1-09 Operation Permit by: REHS date 12-1-09

Authorization to Construct by: REHS date 12-1-09 Existing System Inspection by: date

HEALTH DEPT. COPY: WHITE OWNER COPY (FINAL): YELLOW OWNER COPY (INITIAL): PINK