IREDELL COUNTY HEALTH DEPARTMENT

STATESVILLE 704-878-5305 MOORESVILLE 704-664-5281

IMPROVEMENT PERMIT / AUTHORIZATION TO CONSTRUCT / OPERATION PERMIT / EXISTING SYSTEM INSPECTION

PERMIT# 13226Z PIN# 4740 41 9017.027 4740500843 DATE 11/15/05

OWNER OR APPLICANT Corinthian Bldrs PHONE: Business 704 400 1258 Home

ADDRESS PO BOX 990 Denver NC 28037

LOCATION 115 N, TL Flowerhouse, T L Carlyle, T R Farmdale, TL Greenwood, on Lt

SUBDIVISION Carlyle Farms BLOCK / SECTION LOT 27 LOT AREA 0.845 AC SITE CLASS. PS DESIGN FLOW 360 L.T.A.R. 0.3

Septic Tank: 1000 Gallons; STB 55 Date 8/26/05
Pump Tank: 1600 Gallons; PT Date
Pump Make: Myers Model ME505-11 Serial No.
Nitrification Field: No Fields 1 Square Feet 900 Linear Feet 300
No Lines 3@100' Trench Width 36" Max Trench Bottom Depth 36" Gravel Depth —

☒ New System ☐ Repair ☐ Expansion System Type: I II (III) IV V VI
System Description: Pump 25% Reduction
Repair System Description: Same
Maintenance Agreement Required: ☐ Yes ☒ No

☒ House/Mod. Home No. Bedrooms 3
☐ Mobile Home No. Persons
☐ Business No. Employees
☐ Other


Water Supply: ☐ Individual ☐ Public ☐ Community

☐ Gravity ☒ Pressure ☐ Slab ☒ Crawl Space ☐ Basement w/plumbing ☐ Basement wo/plumbing

Comments:/Conditions:


1" = 40'

INITIAL SITE SKETCH

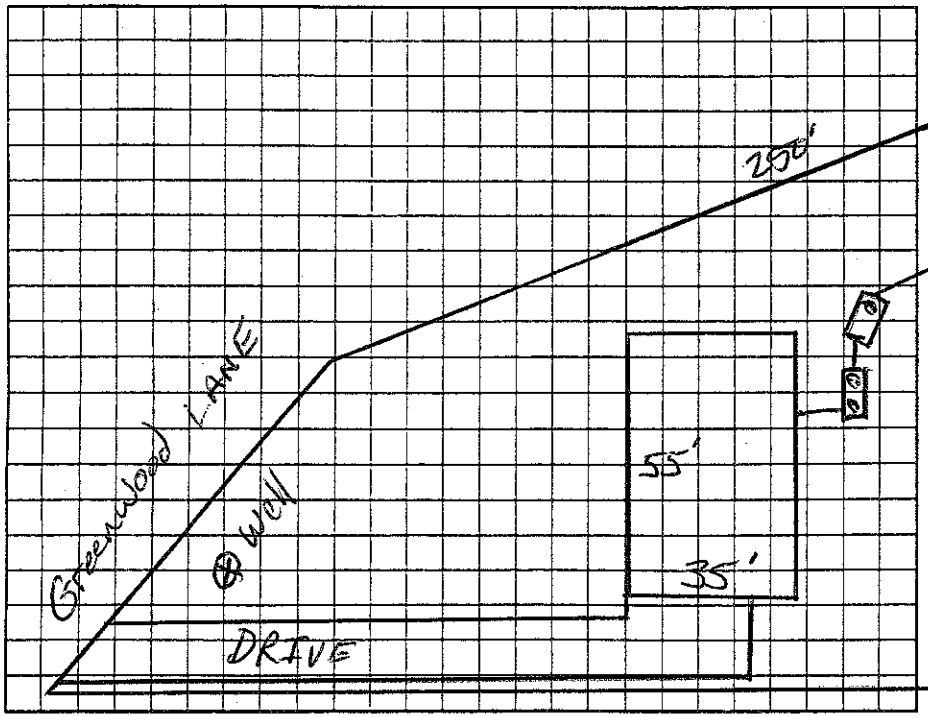

Comments:/Conditions:

AS BUILT SKETCH

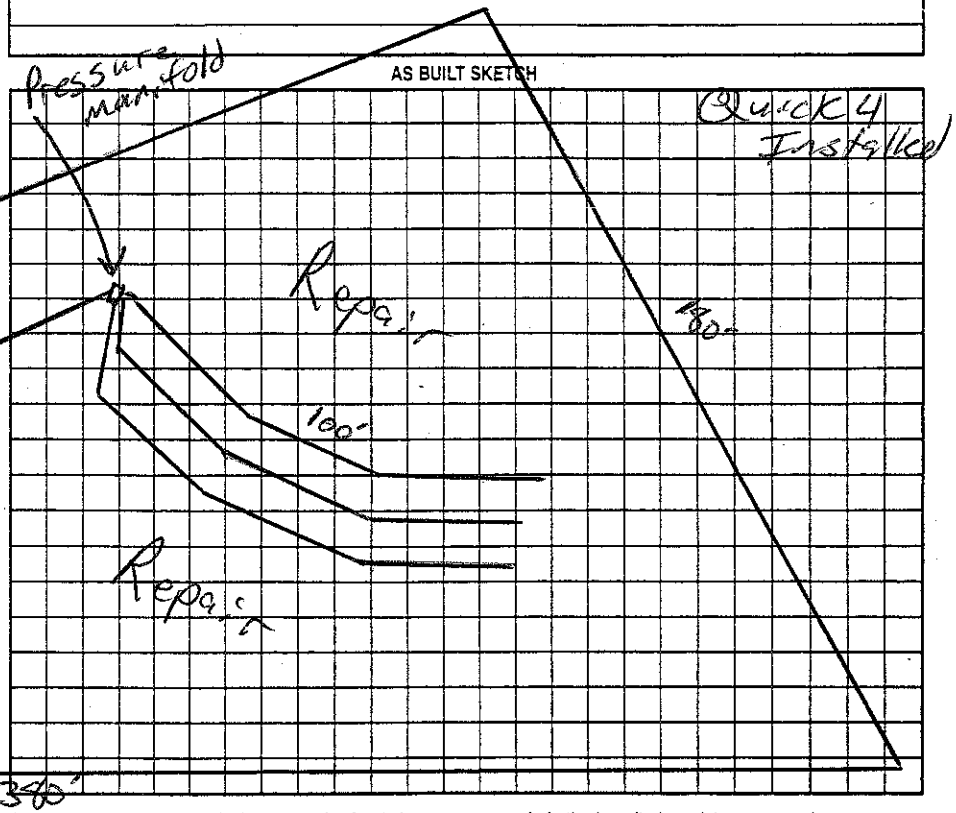

Permit can be suspended or revoked if any false information is supplied toward securing the permit/any unauthorized changes are made to the site/any unauthorized changes are made in the installation of the system. Improvement Permit with plat valid without expiration ☒ Improvement Permit with site plan valid for sixty months ☐ Authorization to Construct is valid for a period equal to that of Improvement Permit – not to exceed sixty months.

Signed: [signature] date 11-17-05 Installed by: Corinthian Bldrs

Improvement Permit by: [signature] RS date 11/15/05 Operation Permit by: [signature] RS date 3/14/06

Authorization to Construct by: [signature] RS date 11/21/05 Existing System Inspection by: date

HEALTH DEPT. COPY: WHITE OWNER COPY (FINAL): YELLOW OWNER COPY (INITIAL): PINK