11:00 - 11:30

IREDELL COUNTY HEALTH DEPARTMENT

STATESVILLE 704-878-5305 MOORESVILLE 704-664-5281

IMPROVEMENT PERMIT / CERTIFICATE OF COMPLETION / OPERATION PERMIT / EXISTING SYSTEM INSPECTION

PROPERTY DESCRIPTION NO. 083567 DATE 9/30/99 TAX MAP NO. 4740 50 2052 Watershed: ☑ Yes ☐ No

OWNER OR CONTRACTOR George Shepard Jr. PHONE: Business Home 871-1578 WS4 PA

ADDRESS 142 Sir George Cir Statesville, NC. 28677

LOCATION HS-21N TL 1st Flower House Loop TL Carlyle on (R) across from 1st Marla Loop

SUBDIVISION Carlyle Farms BLOCK / SECTION 2 LOT 20 LOT AREA .55 SITE CLASS PS DESIGN FLOW 360 L.T.A.R. .3

Alt Pre CCES

Septic Tank: 1000 Gallons; STB 1007 Date 10-4-99

Pump Tank: Gallons; PT Date

Pump Make: Model Serial No.

Nitrification Field: No Fields 1 Square Feet 900 Linear Feet 300*

No Lines 4 @ 75' Trench Width 36" Max Trench Bottom Depth 32" Gravel Depth SAND

☒ New System ☐ Repair System Type: I, II, (III), IV, V, VI

System Description: Gravity - HDS on CH. PLASTIC

Repair System Description: 16" PPBS

Maintenance Agreement Required: ☐ Yes ☒ No

☒ House/Mod. Home No. Bedrooms 3

☐ Mobile Home No. Bathrooms 2.5

☐ Business No. Employees

☐ Other 64'x28'


☐ Slab ☒ Crawl Space ☐ Basement w/plumbing ☐ Basement wo/plumbing

Water Supply: ☒ Individual ☐ Community ☐ Public

Comments: * 25% reduced system, install footage shown on this permit.

Comments: Well NOT installed at time of inspection & Home NOT set up yet. JMD

INITIAL SITE SKETCH

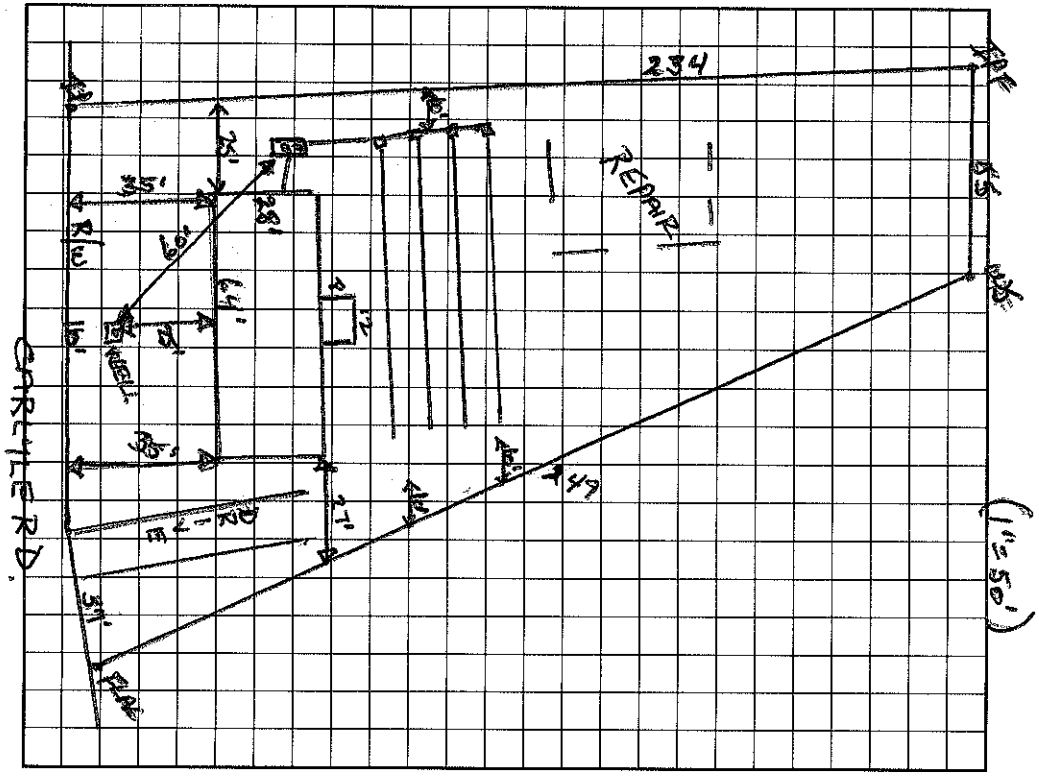

AS BUILT SKETCH

Installed as Drawn

I understand that this permit can be suspended or revoked if any false information is supplied toward securing the permit/any unauthorized changes are made to the site/any unauthorized changes are made in the installation of the system. Improvement Permit is valid for 60 months from date of issuance.

Signed: * George Shepard Jr. 10-1-99

Improvement Permit by: Wesley Sparks R.S. date 9/30/99

Existing System Inspection by: Wesley Sparks R.S. date 9/30/99

Installed by: Donald Lackey

Certificate of Completion by: Marian H. Dotson R.S. date 11/12/99

Operation Permit by: Marian H. Dotson R.S. date 11/12/99

HEALTH DEPT. COPY: WHITE INSPECTION COPY (FINAL): GREEN OWNER COPY (FINAL): YELLOW INSPECTION COPY (INITIAL): PINK OWNER COPY (INITIAL): GOLD