IREDELL COUNTY HEALTH DEPARTMENT

STATESVILLE 704-878-5305 MOORESVILLE 704-664-5281

IMPROVEMENT PERMIT / AUTHORIZATION TO CONSTRUCT / OPERATION PERMIT / EXISTING SYSTEM INSPECTION

PERMIT# 076210 PIN# 4740 50 2894 DATE 9/28/98

OWNER OR CONTRACTOR Carl Forney PHONE: Business 663-0031 Home

ADDRESS 442 W. McLelland St Mooresville, NC. 28118

LOCATION Carlyle Rd. 1.15N TL Flowerhouse Loop, TL Carlyle Rd. on (R) before end Marlo Loop.

SUBDIVISION Carlyle Farms BLOCK / SECTION TT LOT 12 LOT AREA 1.63 Ac SITE CLASS. PS DESIGN FLOW 360 L.T.A.R. .3

Septic Tank: 1000 Gallons; STB 1017 Date 7/31/98
Pump Tank: Gallons; PT Date
Pump Make: Model Serial No.
Nitrification Field: No Fields 1 Square Feet 1200 Linear Feet 400
No Lines 4 Trench Width 36" Max Trench Bottom Depth 36" Gravel Depth 12"

[X] New System ☐ Repair System Type: I (II) III, IV, V, VI
System Description: DIST BOX - CONVENTIONAL
Repair System Description: SAME
Maintenance Agreement Required: ☐ Yes [X] No


[X] House/Mod. Home No. Bedrooms 3
☐ Mobile Home No. Bathrooms 2
☐ Business No. Employees
☐ Other
☐ Slab [X] Crawl Space ☐ Basement w/plumbing ☐ Basement wo/plumbing

Water Supply: [X] Individual ☐ Public ☐ Community


Comments:/Conditions:

Comments:/Conditions:

INITIAL SITE SKETCH

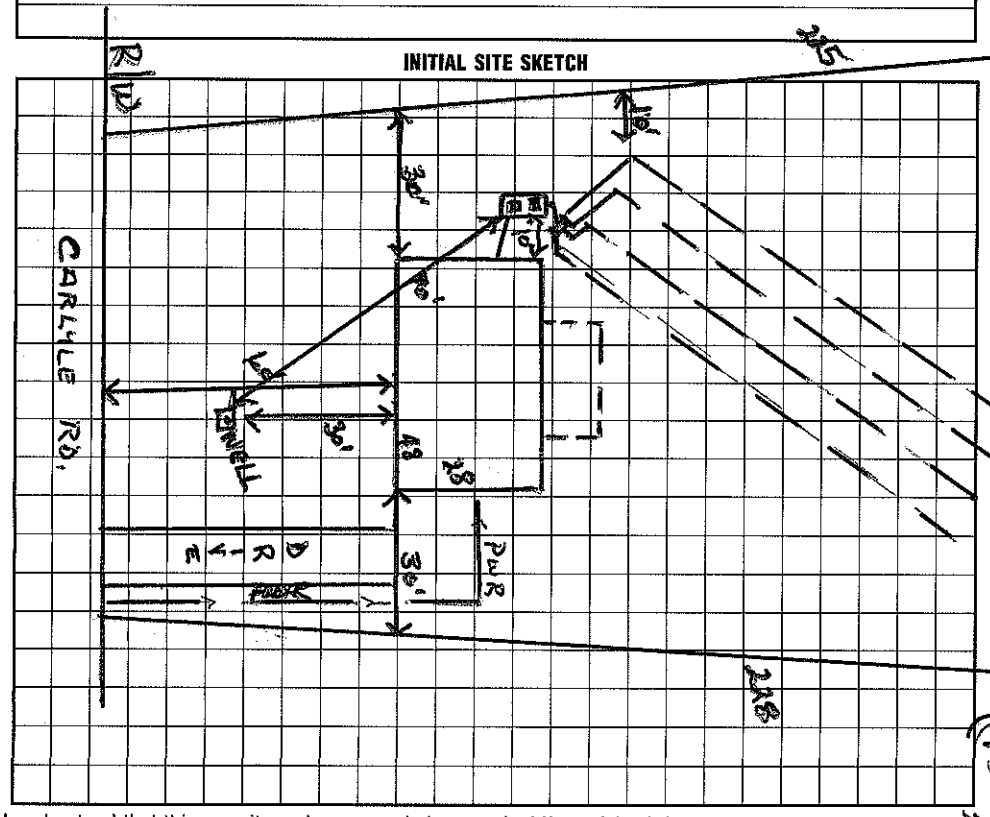

AS BUILT SKETCH

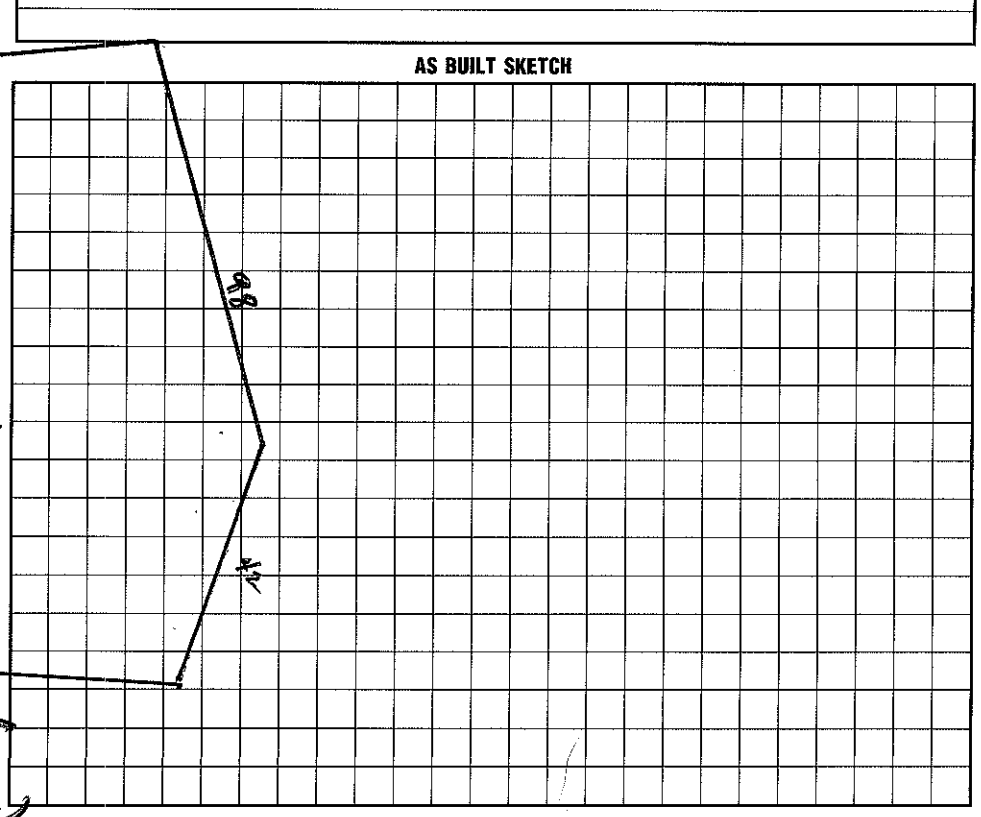

I understand that this permit can be suspended or revoked if any false information is supplied toward securing the permit/any unauthorized changes are made to the site/any unauthorized changes are made in the installation of the system. Improvement Permit with plat valid without expiration. Improvement Permit with site plan valid for sixty months. Authorization to Construct is valid for a period equal to that of Improvement Permit – not to exceed sixty months.

Signed: * date 9/29/98

Improvement Permit by: Wesley Sparks R.S. date 9/28/98

Authorization to Construct by: Wesley Sparks R.S. date 9/28/98

Installed by: A-1 BACKHOE

Operation Permit by: Wesley Sparks R.S. date 10/5/98

Existing System Inspection by: date

HEALTH DEPT. COPY: WHITE INSPECTION COPY (FINAL): GREEN OWNER COPY (FINAL): YELLOW INSPECTION COPY (INITIAL): PINK OWNER COPY (INITIAL): GOLD