IREDELL COUNTY HEALTH DEPARTMENT

STATESVILLE 704-878-5305 130.00 Paid MOORESVILLE 704-664-5281 CA4482 IND 12/11/03 RLS

IMPROVEMENT PERMIT / AUTHORIZATION TO CONSTRUCT / OPERATION PERMIT / EXISTING SYSTEM INSPECTION

PERMIT# 116274 PIN# 4740 50 3313 DATE 11/7/03

OWNER OR CONTRACTOR Fleetwood Homes of Troutman PHONE: Business 704-528-7120 Home

ADDRESS 1040 Charlotte Hwy Troutman, NC. 28166 / 204 CARLYLE RD.

LOCATION 115-21 N TL Fleetwood Homes Lp TL Carlyle Rd. on (R) just past 2nd Mailo Loop.

SUBDIVISION Carlyle Farms BLOCK / SECTION 2 LOT 17 LOT AREA .51 SITE CLASS. PS DESIGN FLOW 360 L.T.A.R. .3

Septic Tank: 1000 Gallons; STB 794 Date 9/20/03
Pump Tank: 1000 Gallons; PT 27 Date 10/24/03
Pump Make: Zoeller Model N152-A Serial No.
Nitrification Field: No Fields 1 Square Feet 900 Linear Feet 300
No Lines 4 @ 75' Trench Width 3' Max Trench Bottom Depth 3'

[X] New System [ ] Repair System Type: I, II, (III), IV, V, VI
System Description: Pres Manifold – Type 3
Repair System Description: Pres. Dosed 16" PP/BPS
Maintenance Agreement Required: [ ] Yes [ ] No

[ ] House/Mod. Home No. Bedrooms 3
[X] Mobile Home No. Bathrooms 2
[ ] Business No. Employees
[ ] Other
[ ] Slab [X] Crawl Space [ ] Basement w/plumbing [ ] Basement wo/plumbing Gravel Depth N/A


Water Supply: [X] Individual [ ] Public [ ] Community

Comments:/Conditions:


Comments:/Conditions:

1" = 50'

INITIAL SITE SKETCH

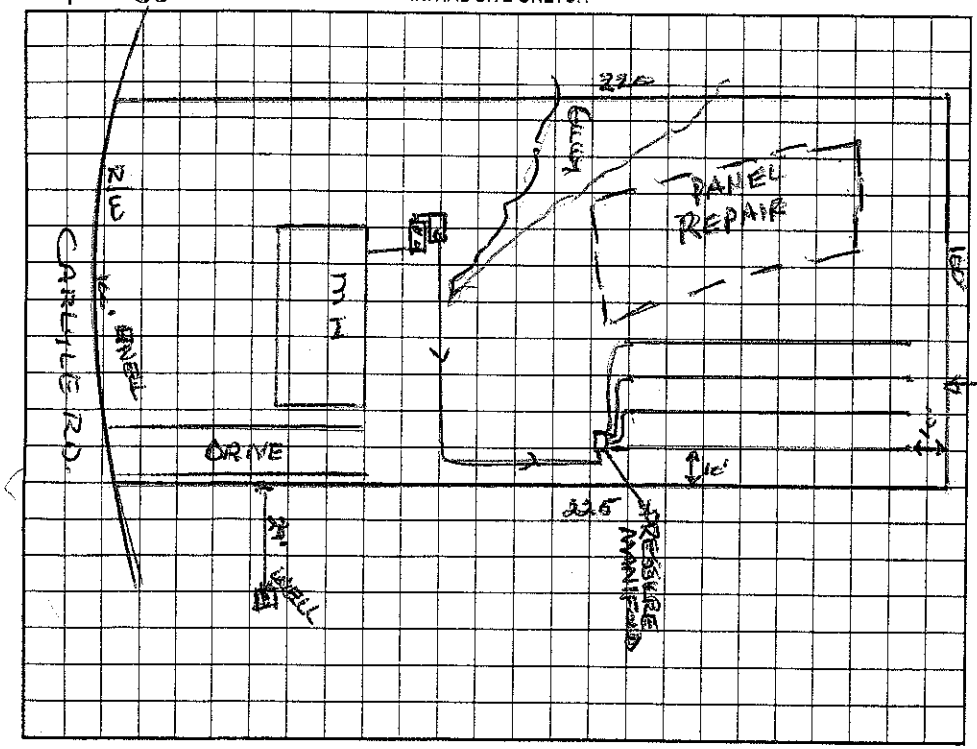

AS BUILT SKETCH

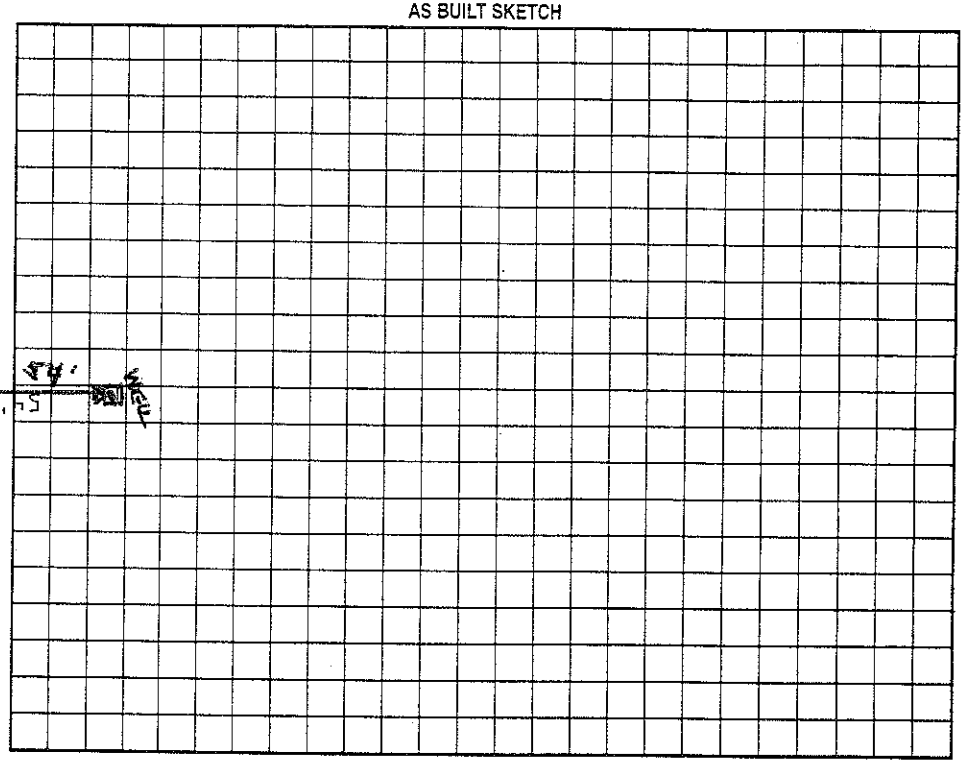

Permit can be suspended or revoked if any false information is supplied toward securing the permit/any unauthorized changes are made to the site/any unauthorized changes are made in the installation of the system. Improvement Permit with plat valid without expiration. Improvement Permit with site plan valid for sixty months. Authorization to Construct is valid for a period equal to that of Improvement Permit – not to exceed sixty months.

Signed: + Dave Nichols date 11/10/03 Installed by: Madison Bros.

Improvement Permit by: Wesley Sparks RS. date 11/7/03 Operation Permit by: Wesley Sparks RS. date 12/11/03

Authorization to Construct by: Wesley Sparks RS. date 11/7/03 Existing System Inspection by: date

HEALTH DEPT. COPY: WHITE OWNER COPY (FINAL): YELLOW OWNER COPY (INITIAL): PINK