IREDELL COUNTY HEALTH DEPARTMENT

Authorization to Construct

STATESVILLE 704-878-5305 MOORESVILLE 704-664-5281

ANR 4740-SD-3413

IMPROVEMENT PERMIT / ~~CERTIFICATE OF COMPLETION~~ / OPERATION PERMIT / EXISTING SYSTEM INSPECTION

PROPERTY DESCRIPTION NO. 22743 DATE 12/14/95 TAX MAP NO. 4E A 62 Pt of Watershed: ☐ Yes ☒ No

OWNER OR CONTRACTOR Robert B Ledford PHONE: Business _____ Home _____

ADDRESS 2320 Sloop Rd. Mooresville

LOCATION Carlyle Rd. off Flowers Chapel Rd. on R across from first entrance to Carlyle Farm

SUBDIVISION Carlyle Farm BLOCK / SECTION II LOT 16 LOT AREA 1.516 SITE CLASS. PS DESIGN FLOW 360 L.T.A.R. .3

Septic Tank: 1000 Gallons; STB 825 Date 10/25/95

Pump Tank: _____ Gallons; PT _____ Date _____

Pump Make: _____ Model _____ Serial No. _____

Nitrification Field: No Fields 1 Square Feet 1200 Linear Feet 400

No Lines 4 Trench Width 36" Max Trench Bottom Depth 36" Gravel Depth 12"

☒ New System ☐ Repair System Type: I (II) III, IV, V, VI

System Description: CONV - 1 1ST BOX

Repair System Description: Same

Maintenance Agreement Required: ☐ Yes ☒ No

☒ House/Mod. Home No. Bedrooms 3

☐ Mobile Home No. Bathrooms 2

☐ Business No. Employees _____

☐ Other _____


☐ Slab ☒ Crawl Space ☐ Basement w/plumbing ☐ Basement wo/plumbing

Water Supply: ☒ Individual ☐ Community ☐ Public


Comments:

Comments:

INITIAL SITE SKETCH

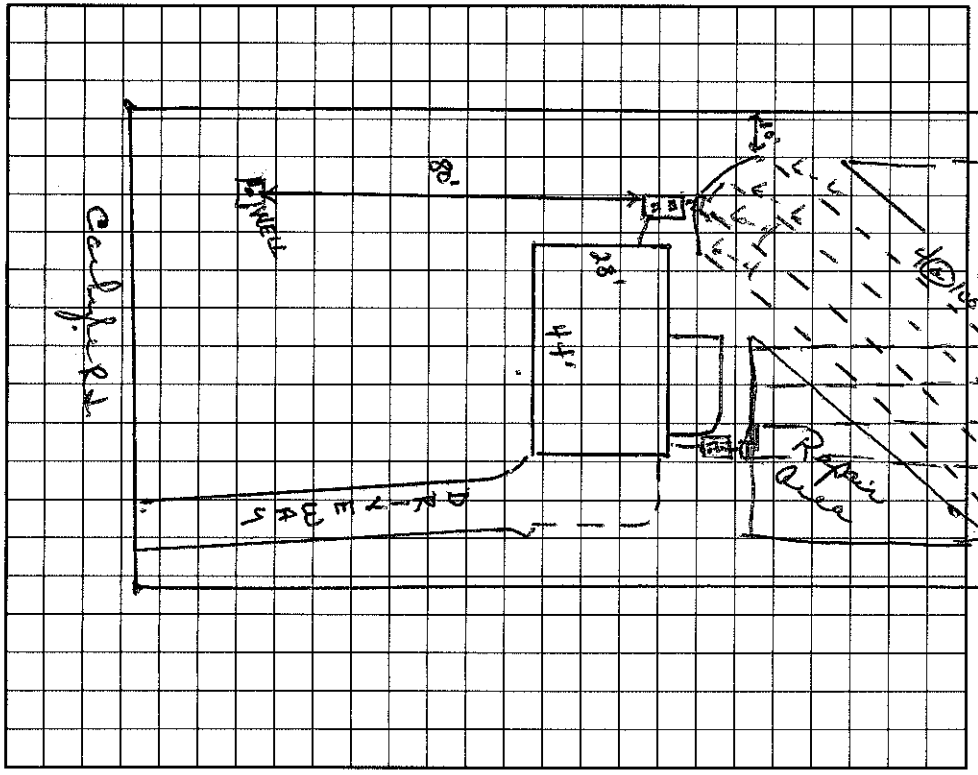

AS BUILT SKETCH

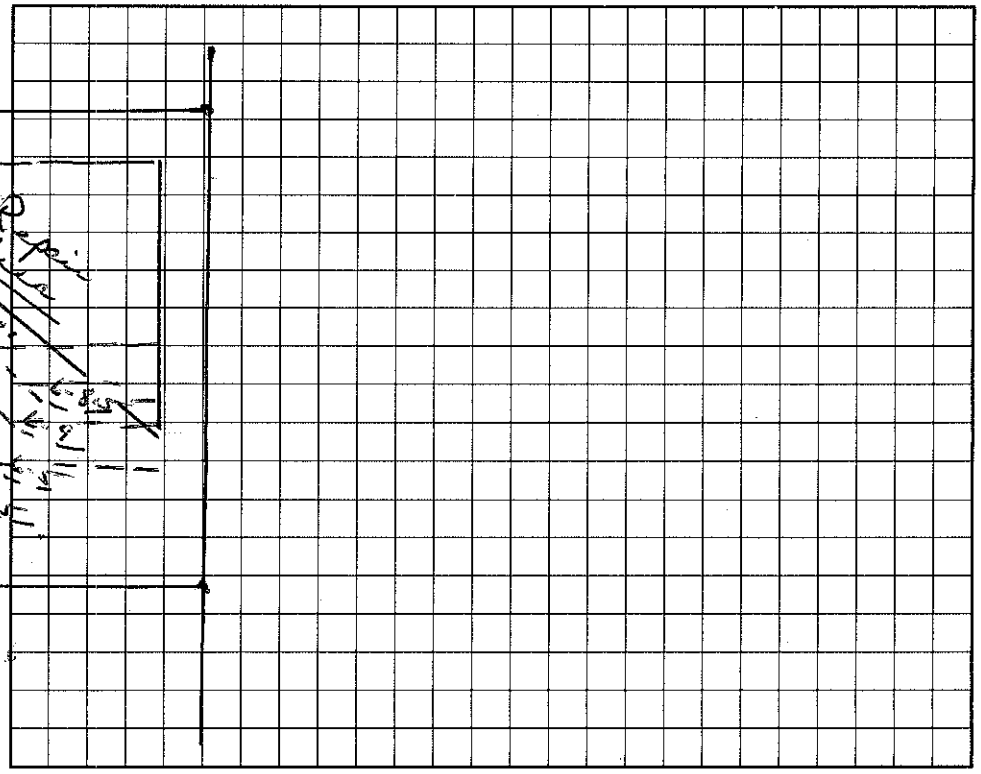

I understand that this permit can be suspended or revoked if any false information is supplied toward securing the permit/any unauthorized changes are made to the site/any unauthorized changes are made in the installation of the system.

Signed: Wayne Ervin

Improvement Permit by: Wesley Sparks RS. date 12/14/95

Existing System Inspection by: Wesley Sparks RS. date 12/14/95

Installed by: Rowan Septic Tank Co.

Certificate of Completion by: _____ date _____

Operation Permit by: Wesley Sparks RS. date 2/27/96

HEALTH DEPT. COPY: WHITE INSPECTION COPY (FINAL): GREEN OWNER COPY (FINAL): YELLOW INSPECTION COPY (INITIAL): PINK OWNER COPY (INITIAL): GOLD