IREDELL COUNTY HEALTH DEPARTMENT

STATESVILLE 704-878-5305 MOORESVILLE 704-664-5281

IMPROVEMENT PERMIT / ~~CERTIFICATE OF COMPLETION~~ / OPERATION PERMIT / EXISTING SYSTEM INSPECTION

Authorization to construct

PROPERTY DESCRIPTION NO. 069162 DATE 9/24/97 TAX MAP NO. 4770503503 Watershed: ☑ Yes ☐ No

OWNER OR CONTRACTOR PIEDMONT HOUSING PHONE: Business 525-7120 Home

ADDRESS 1040 CHARLOTTE ~~HWY~~ TROUTMAN NC 28166

LOCATION 21 N TL FLOWER HOUSE LOOP - TL CARLYLE RD - ON RT

SUBDIVISION CARLYLE FARMS BLOCK / SECTION 2 LOT 15 LOT AREA .92 AC SITE CLASS. 05 DESIGN FLOW 360 L.T.A.R. .3

Septic Tank: 1000 Gallons; STB 821 Date 10/16/97

Pump Tank: Gallons; PT Date

Pump Make: Model Serial No.

Nitrification Field: No Fields 1 Square Feet 1200 Linear Feet 400

No Lines 5 @ 80' Trench Width 36" Max Trench Bottom Depth 36" Gravel Depth 12"

☑ New System ☐ Repair System Type: I, II, III, IV, V, VI

System Description: GRAVITY CONVENTIONAL

Repair System Description: GRAVITY PANEL

Maintenance Agreement Required: ☐ Yes ☑ No

☐ House/Mod. Home ☑ Mobile Home ☐ Business ☐ Other

No. Bedrooms 3 No. Bathrooms 2 No. Employees


☐ Slab ☑ Crawl Space ☐ Basement w/plumbing ☐ Basement wo/plumbing

Water Supply: ☑ Individual ☐ Community ☐ Public


Comments:

Comments:

INITIAL SITE SKETCH 1" = 40'

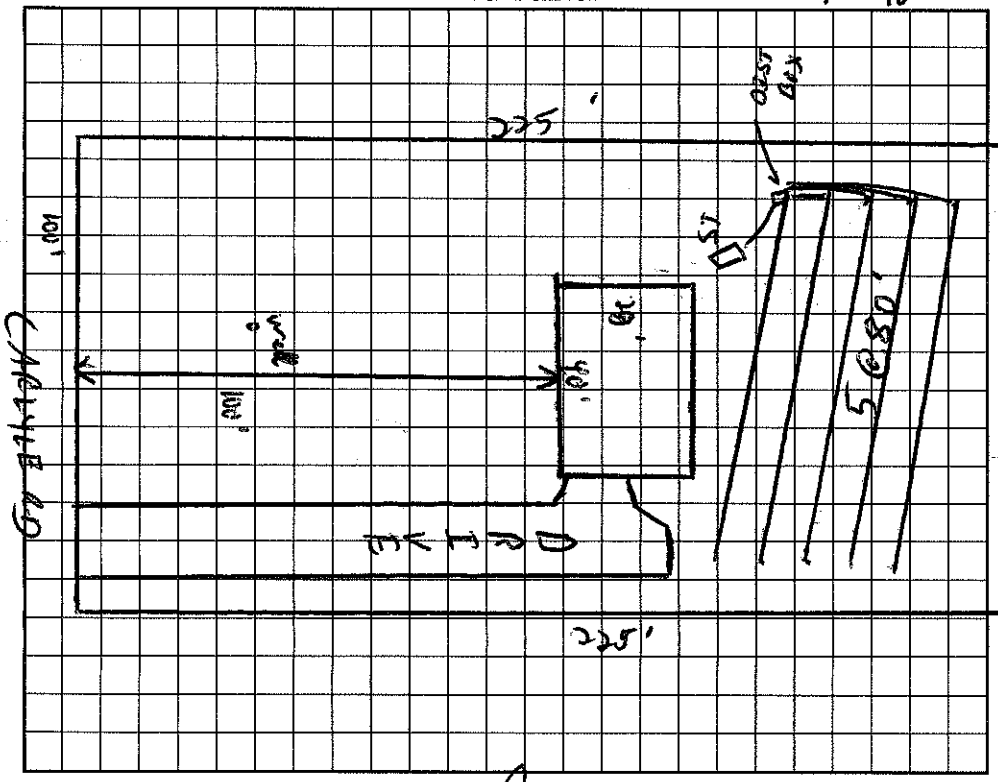

AS BUILT SKETCH

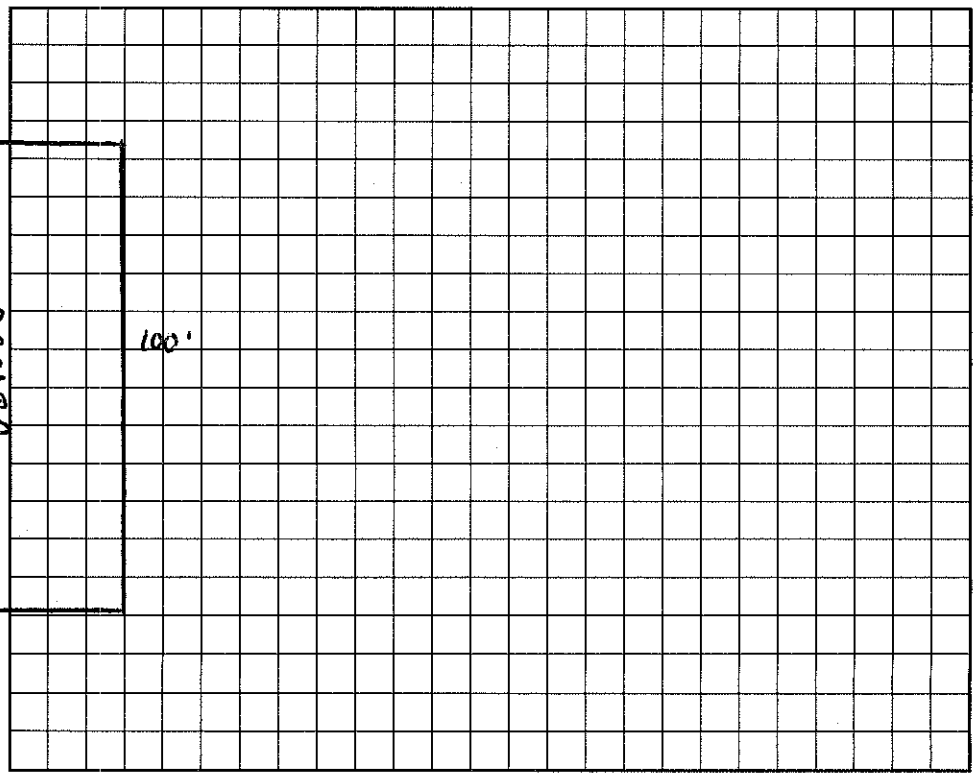

I understand that this permit can be suspended or revoked if any false information is supplied toward securing the permit/any unauthorized changes are made to the site/any unauthorized changes are made in the installation of the system. Improvement Permit is valid for 60 months from date of issuance.

Signed: Jason Wood

Improvement Permit by: C. Ray Stevens RS date 9/24/97

Authorization to ~~Existing System Inspection by:~~ C. Ray Stevens RS date 9/24/97 construct

Installed by: D + M Enterprise

Certificate of Completion by: Wesley Sparks RS. date 11/19/97

Operation Permit by: Wesley Sparks RS. date 11/19/97

HEALTH DEPT. COPY: WHITE INSPECTION COPY (FINAL): GREEN OWNER COPY (FINAL): YELLOW INSPECTION COPY (INITIAL): PINK OWNER COPY (INITIAL): GOLD