3:30

IREDELL COUNTY HEALTH DEPARTMENT

STATESVILLE 704-878-5305 MOORESVILLE 704-664-5281

IMPROVEMENT PERMIT / CERTIFICATE OF COMPLETION / OPERATION PERMIT / EXISTING SYSTEM INSPECTIO

PROPERTY DESCRIPTION NO. 070196 DATE 11/21/97 TAX MAP NO. 4740503603 Watershed: ☒ Yes ☐ No

OWNER OR CONTRACTOR Kelly Morse PHONE: Business Home

ADDRESS 213 West Pressley Ave Mooresville NC 28115

LOCATION 190 Carlyle Rd - Flower House Loop TR Carlyle on Right before Marlo Loop

SUBDIVISION Carlyle Farms BLOCK / SECTION 2 LOT 14 LOT AREA .52Acres SITE CLASS. PS DESIGN FLOW 300gpd L.T.A.R. .3

Septic Tank: 1000 Gallons; STB 799 Date 10/8/97

Pump Tank: Gallons; PT Date

Pump Make: Model Serial No.

Nitrification Field: No Fields 1 Square Feet 1200 Linear Feet 400'

No Lines 5 at 80' Trench Width 36" Max Trench Bottom Depth 30" Gravel Depth 12"

☒ New System ☐ Repair System Type: I, II, III, IV, V, VI

System Description: Gravity - Conventional

Repair System Description Gravity - Conventional

Maintenance Agreement Required: ☐ Yes ☐ No

☒ House/Mod. Home ☐ Mobile Home ☐ Business ☐ Other

No. Bedrooms 3 No. Bathrooms 2 No. Employees


☐ Slab ☒ Crawl Space ☐ Basement w/plumbing ☐ Basement wo/plumbing

Water Supply: ☒ Individual ☐ Community ☐ Public


Comments: Well must be "Drilled Well" Keep Septic System 10' From Property lines

Comments: UPPER 3 LEVELS decked

INITIAL SITE SKETCH Scale 1:50

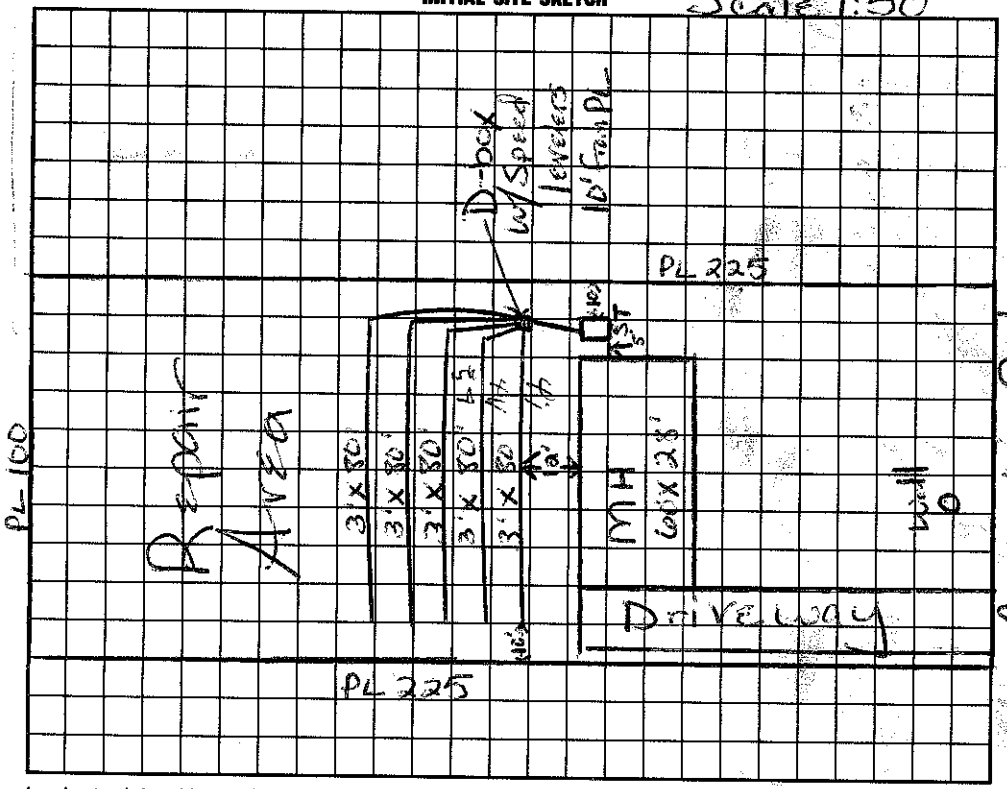

AS BUILT SKETCH

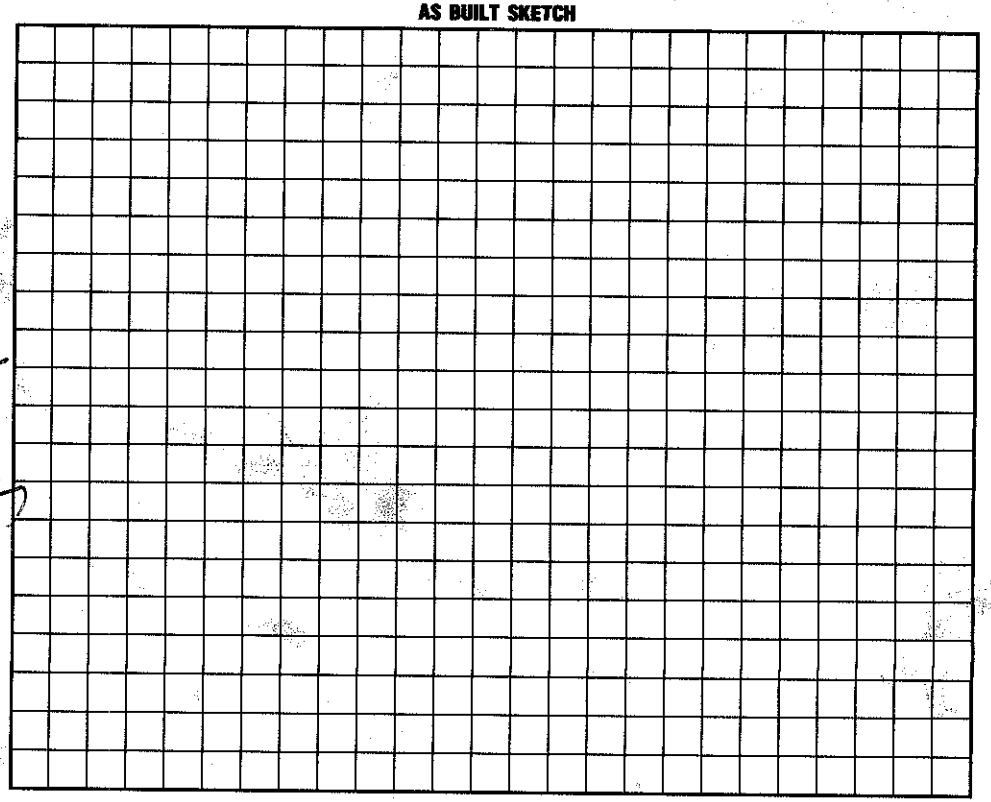

I understand that this permit can be suspended or revoked if any false information is supplied toward securing the permit/any unauthorized changes are made to the site/any unauthorized changes are made in the installation of the system. Improvement Permit is valid for 60 months from date of issuance.

Signed: Kelly Morse

Improvement Permit by: Marie H. Dotson date 11/21/97

Existing System Inspection by: Marie H. Dotson date 11/21/97

Installed by: ACE GENERAL CONTRACTING

Certificate of Completion by: date

Operation Permit by: C. Tom date 1/28/98

Const Auth.

HEALTH DEPT. COPY: WHITE INSPECTION COPY (FINAL): GREEN OWNER COPY (FINAL): YELLOW INSPECTION COPY (INITIAL): PINK OWNER COPY (INITIAL): GOLD