# IREDELL COUNTY HEALTH DEPARTMENT

AUTHORIZATION TO CONSTRUCT (10:30)

STATESVILLE 704-878-5305 MOORESVILLE 704-664-5281

## IMPROVEMENT PERMIT / ~~CERTIFICATE OF COMPLETION~~ / OPERATION PERMIT / EXISTING SYSTEM INSPECTION

PROPERTY DESCRIPTION NO. 06 7913 DATE 7/25/97 TAX MAP NO. 4740503 704 Q Watershed: ☐ Yes ☒ No

OWNER OR CONTRACTOR TOMMY L. TORRENCE PHONE: Business _____ Home _____

ADDRESS 980 RUSH ST MOORESVILLE NC 28115

LOCATION PERTH RD N - TR FERN HILL - TL CARLYLE RD. ON LEFT PAST 1ST MARLO LOOP

SUBDIVISION CARLYLE FARMS BLOCK / SECTION 2 LOT 13 LOT AREA — SITE CLASS. PS DESIGN FLOW 360 L.T.A.R. .3

Septic Tank: 1000 Gallons; STB 821 Date 7/4/97

Pump Tank: _____ Gallons; PT _____ Date _____

Pump Make: _____ Model _____ Serial No. _____

Nitrification Field: No Fields 1 Square Feet 900 Linear Feet 300

No Lines 4@75' Trench Width 36" Max Trench Bottom Depth 36" Gravel Depth N/A

☒ New System ☐ Repair System Type: I, II, (III) IV, V, VI

System Description: GRAVITY CHAMBERED

Repair System Description: PANEL

Maintenance Agreement Required: ☐ Yes ☒ No

☐ House/Mod. Home ☒ Mobile Home ☐ Business ☐ Other

No. Bedrooms 3 No. Bathrooms 2 No. Employees ____


☐ Slab ☒ Crawl Space ☐ Basement w/plumbing ☐ Basement wo/plumbing

Water Supply: ☒ Individual ☐ Community ☐ Public


Comments:

Comments: A well not installed at time of O.P. inspection.

**INITIAL SITE SKETCH** 1"=40'

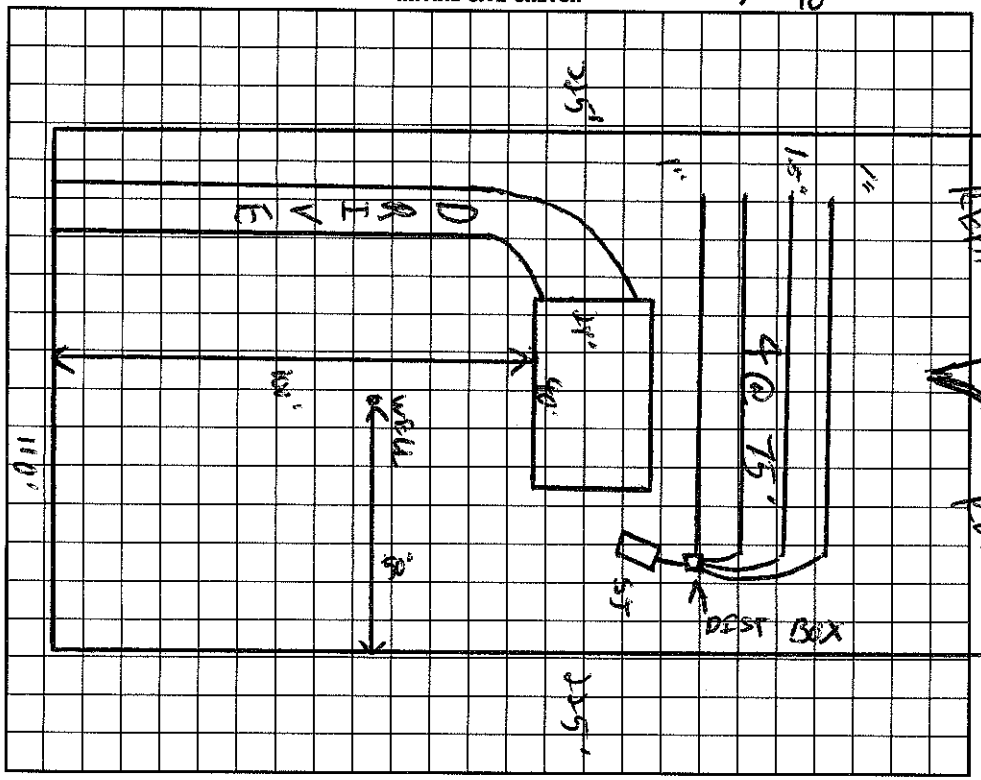


**AS BUILT SKETCH**

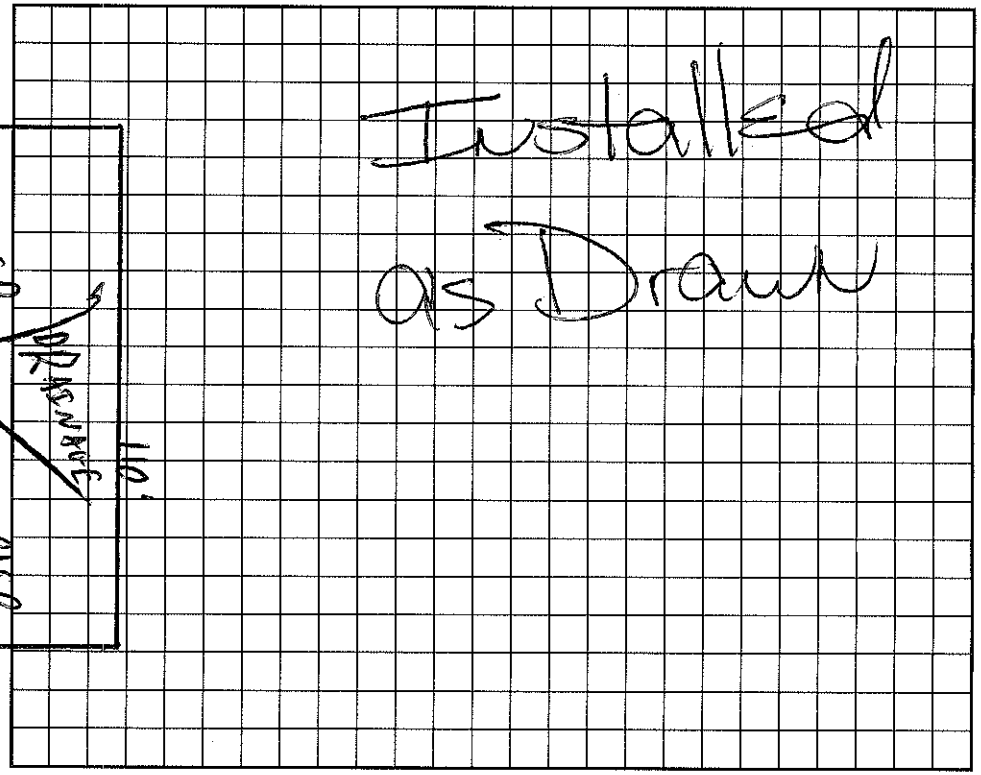


I understand that this permit can be suspended or revoked if any false information is supplied toward securing the permit/any unauthorized changes are made to the site/any unauthorized changes are made in the installation of the system. Improvement Permit is valid for 60 months from date of issuance.

Signed: Joe Potts for Vicent Hoy.

Improvement Permit by: C. Rudy Fesperman date 7/25/97

AUTHORIZATION TO CONSTRUCT Existing System Inspection by: C Rudy Fesperman date 7/25/97

Installed by: G&M Enterprise

Certificate of Completion by: Maria H. Dotson date 8/7/97

Operation Permit by: Maria H. Dotson date 8/7/97

HEALTH DEPT. COPY: WHITE INSPECTION COPY (FINAL): GREEN OWNER COPY (FINAL): YELLOW INSPECTION COPY (INITIAL): PINK OWNER COPY (INITIAL): GOLD