IREDELL COUNTY HEALTH DEPARTMENT

STATESVILLE 704-878-5305 MOORESVILLE 704-664-5281

IMPROVEMENT PERMIT / AUTHORIZATION TO CONSTRUCT / OPERATION PERMIT / EXISTING SYSTEM INSPECTION

PERMIT# 102928 PIN# 4740-50-5298 DATE 10/22/01

OWNER OR CONTRACTOR Oakwood Homes / Joseph Jordan PHONE: Business 704-528-4516 Home

ADDRESS 1042 Charlotte Hwy Troutman NC 28166

LOCATION 21 N, TR Flowerhouse Ln, TR Carlyle on Lt. (209 Carlyle)

SUBDIVISION BLOCK / SECTION LOT LOT AREA 0.61 AC SITE CLASS PS DESIGN FLOW 360 L.T.A.R.

Septic Tank: Existing Gallons; STB Date

Pump Tank: Gallons; PT Date

Pump Make: Model Serial No.

Nitrification Field: No Fields Square Feet ~~Linear Feet~~ EXIST/UNK

No Lines Trench Width EXIST/UNK ~~Max Trench Bottom Depth~~ Gravel Depth

☐ New System ☐ Repair System Type: I (II) III. IV. V. VI

System Description: Existing - Conventional

Repair System Description:

Maintenance Agreement Required: ☐ Yes ☐ No

☐ House/Mod. Home ☒ Mobile Home ☐ Business ☐ Other

No. Bedrooms 3 No. Bathrooms 2 No. Employees

☐ Slab ☒ Crawl Space ☐ Basement w/plumbing ☐ Basement wo/plumbing


Water Supply: ☒ Individual ☐ Public ☐ Community

Comments:/Conditions:

Comments:/Conditions:

INITIAL SITE SKETCH

AS BUILT SKETCH

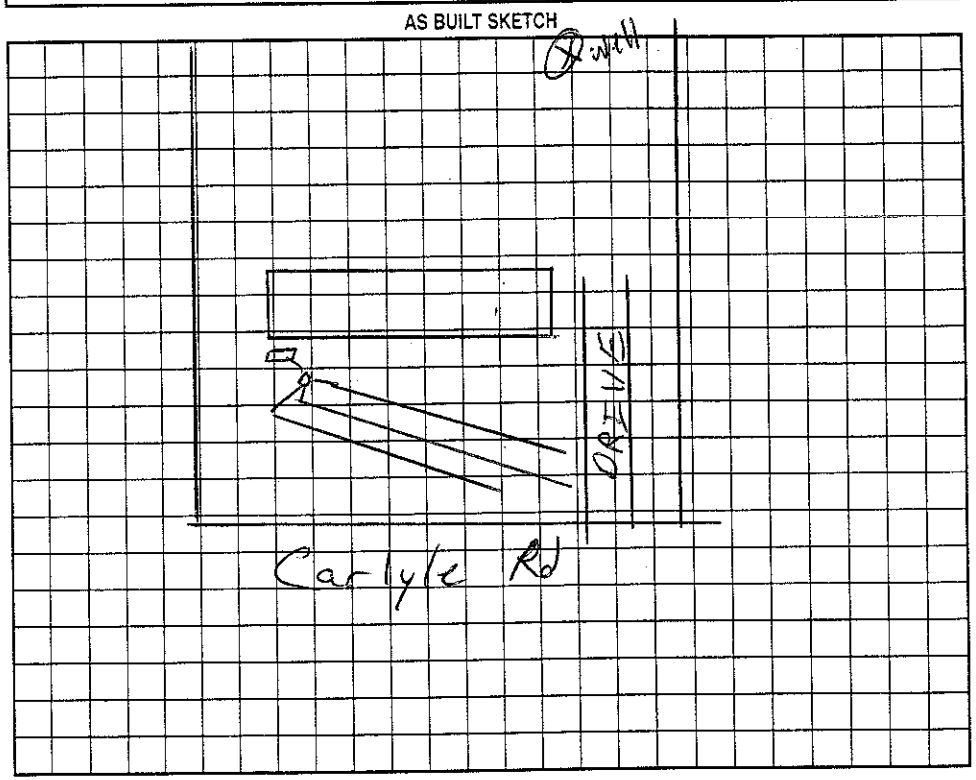

Permit can be suspended or revoked if any false information is supplied toward securing the permit/any unauthorized changes are made to the site/any unauthorized changes are made in the installation of the system. Improvement Permit with plat valid without expiration. Improvement Permit with site plan valid for sixty months. Authorization to Construct is valid for a period equal to that of Improvement Permit – not to exceed sixty months.

Signed: [signature] date 10-24-01 Installed by:

Improvement Permit by: date Operation Permit by: date

Authorization to Construct by: date Existing System Inspection by: [signature] RSI date 10/22/01

HEALTH DEPT. COPY: WHITE OWNER COPY (FINAL): YELLOW OWNER COPY (INITIAL): PINK