IREDELL COUNTY HEALTH DEPARTMENT

STATESVILLE 704-878-5305 MOORESVILLE 704-664-5281

IMPROVEMENT PERMIT / AUTHORIZATION TO CONSTRUCT / OPERATION PERMIT / EXISTING SYSTEM INSPECTION

PERMIT# 11573 PIN# 4740507620 DATE 9/8/03

OWNER OR CONTRACTOR Thomas John Development PHONE: Business (704) 562-6427 Home

ADDRESS P.O. Box 1149 Cornelius, NC 28031

LOCATION Hwy 115 N TL Flowerhouse TL Carlyle TL Marlo Loop

SUBDIVISION Carlyle Farms BLOCK / SECTION LOT 3 LOT AREA SITE CLASS. PS DESIGN FLOW 360 gpd L.T.A.R.

Septic Tank: Existing Gallons; STB Date

Pump Tank: Gallons; PT Date

Pump Make: Model Serial No.

Nitrification Field: No Fields 1 Square Feet 720 Linear Feet 240

No Lines 3@80' Trench Width Existing Max Trench Bottom Depth Gravel Depth 12"

☐ New System ☐ Repair System Type: I (II) III, IV, V, VI

System Description: Existing Gravity - Conventional

Repair System Description:

Maintenance Agreement Required: ☐ Yes ☒ No

☐ House/Mod. Home ☒ Mobile Home ☐ Business ☐ Other

No. Bedrooms 3 No. Bathrooms 2 No. Employees


☐ Slab ☒ Crawl Space ☐ Basement w/plumbing ☐ Basement wo/plumbing

Water Supply: ☐ Individual ☒ Public ☒ Community

Comments:/Conditions: Existing Septic System appears to be functioning okay at time of inspection, no problems noticed

Comments:/Conditions: Septic System originally installed in 1985 under Marlo Corp. (Copy of permit attached)

INITIAL SITE SKETCH ☒ Not to Scale

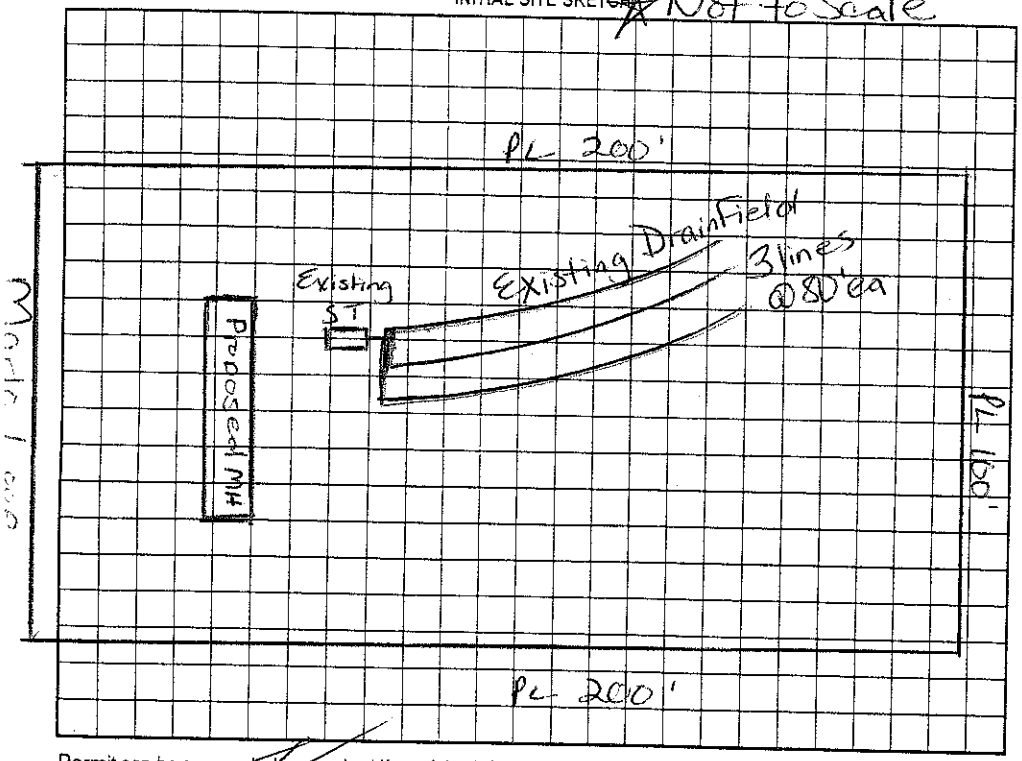

AS BUILT SKETCH

Permit can be suspended or revoked if any false information is supplied toward securing the permit/any unauthorized changes are made to the site/any unauthorized changes are made in the installation of the system. Improvement Permit with plat valid without expiration. Improvement Permit with site plan valid for sixty months. Authorization to Construct is valid for a period equal to that of Improvement Permit – not to exceed sixty months.

Signed:

Improvement Permit by: Maria H. Dotson RS date 9/8/03

Authorization to Construct by: date

Installed by:

Operation Permit by: date

Existing System Inspection by: Maria H. Dotson RS date 9/8/03

HEALTH DEPT. COPY: WHITE OWNER COPY (FINAL): YELLOW OWNER COPY (INITIAL): PINK