IREDELL COUNTY HEALTH DEPARTMENT

STATESVILLE 704-878-5305 MOORESVILLE 704-664-5281

IMPROVEMENT PERMIT / AUTHORIZATION TO CONSTRUCT / OPERATION PERMIT / EXISTING SYSTEM INSPECTION

PERMIT# 095420 PIN# 4740508620 DATE 7-19-2001

OWNER OR CONTRACTOR Lester Howell (Kevin) PHONE: Business Home 663-6559

ADDRESS 248 Judas Rd Mooresville, NC 28115

LOCATION 21N TR Flower House TR Carlyle TL Mario Lp 2nd on left

SUBDIVISION Carlyle Farms BLOCK / SECTION 1 LOT 4 LOT AREA .46 Acre SITE CLASS. PS DESIGN FLOW 360gpd L.T.A.R.

Septic Tank: Existing Gallons: STB Date

Pump Tank: Existing Gallons: PT Date

Pump Make: Model Serial No.

Nitrification Field: No Fields Existing Square Feet Linear Feet

No Lines Trench Width Existing Max Trench Bottom Depth Gravel Depth

☐ New System ☐ Repair System Type: I, II, III, IV, V, VI

System Description: Existing Gravity Conventional

Repair System Description:

Maintenance Agreement Required: ☐ Yes ☐ No

☐ House/Mod. Home ☒ Mobile Home ☐ Business ☐ Other

No. Bedrooms 3 No. Bathrooms 2 No. Employees


☐ Slab ☒ Crawl Space ☐ Basement w/plumbing ☐ Basement wo/plumbing

Water Supply: ☒ Individual ☐ Public ☐ Community


Comments:/Conditions: Existing Septic System appears to be functioning Okay. No problems noticed at time of inspection

Comments:/Conditions: Okay to put 3Bedroom MH on. Keep New Home at least 5' From Septic System.

☆ Not to Scale INITIAL SITE SKETCH

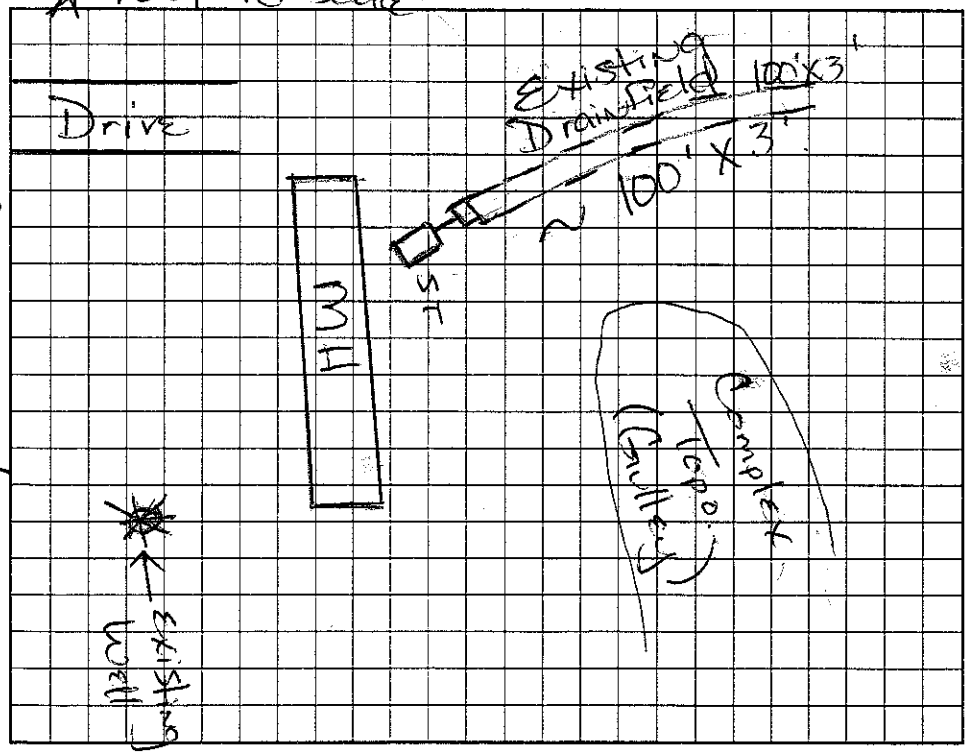

AS BUILT SKETCH

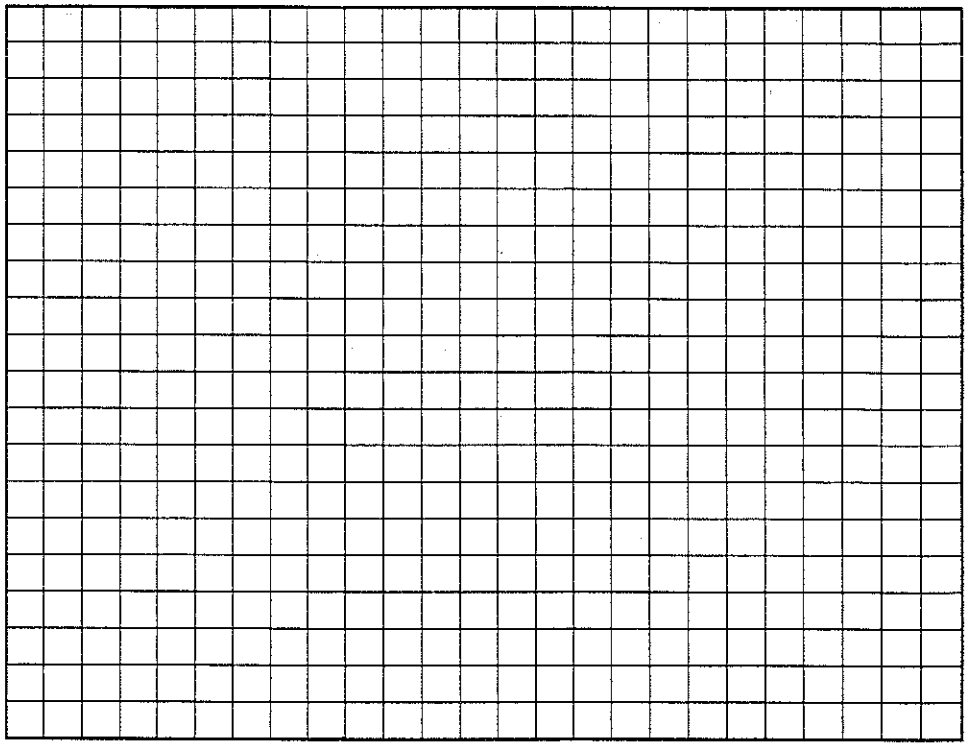

Permit can be suspended or revoked if any false information is supplied toward securing the permit/any unauthorized changes are made to the site/any unauthorized changes are made in the installation of the system. Improvement Permit with plat valid without expiration. Improvement Permit with site plan valid for sixty months. Authorization to Construct is valid for a period equal to that of Improvement Permit – not to exceed sixty months.

Signed Lester D Howell date Installed by:

Improvement Permit by: Maria H. H Dotson R.S. date 4/19/2001 Operation Permit by: date

Authorization to Construct by: date Existing System Inspection by: Maria H H Dotson R.S. date 4/19/2001

HEALTH DEPT. COPY: WHITE OWNER COPY (FINAL): YELLOW OWNER COPY (INITIAL): PINK

IREDELL COUNTY
PROPERTY DESCRIPTION FORM
P.O. BOX 788 277 S. CENTER ST.
STATESVILLE, NC 28687
Call Sanitarian Between
8 a.m. and 9 a.m.
664-5281 / 878-5305

Permit No: 095420 Zoning Permit: X Improvements Permit: 2

Name: HOWELL KEVIN Address: 248 JUDAS RD

City: MOORESVILLE State: NC Zip: 281150000

Phone: 7046636559

Proposed Use: 02

PIN #: 4740 50 8620 Zoning: RA Township: 1600

Street Address: 119 MARLO LP

Flood Zone: Plan Review Deposit: Date Received: / /

Subdivision/MHP: CARLYLE FARM S-1Lot #: 4 Lot Size: .46

Has Property been recorded? Y Community Water? N Sewer? N

Provider:

Watershed: WSIVPA Approximate Area to be Disturbed: 0

Total Built-upon Area: 0 Erosion Plan Required?

Setbacks: F35 S15 R35

Minimum Lot Size: 21780 Minimum Lot Width: 100

Land Use Permitted in this Zoning District? Y

Comments: MUST BE PARALLEL TO FRONT LINE;HIDE TOWING APP;CONT UNDERSKI

Hold Building Permits? N Reason: 32 SQ FT DECK ON FRONT

Location: 21S,R FLOWER,R CARLYLE,L MARLO LOOP,2ND ON L

Staff: SBW Date: 03/26/01

Fees: Zoning: $ 31.50 Health: $ 50.00

Signature of Applicant: Lester Howell
Owner: Agent: