IREDELL COUNTY HEALTH DEPARTMENT

(SEPTIC TANK) IMPROVEMENTS PERMIT AND CERTIFICATE OF COMPLETION

(Ground Absorption Sewage Disposal System -- G. S. Chapter 130-Article 13C)

OWNER OR CONTRACTOR Marlo Corp DATE 10/10/85 PERMIT NO. 442

PHONE: Business _____ Home _____

LOCATION 115N, R on 1312 LF on 1313, 3/4 mile go LF onto 1st Marlo Loop, Lot on LR S. R. No. _____

SUBDIVISION NAME Carlisle Farms LOT NO. 4 SECTION OR BLOCK NO. _____

House (✓) Mobile Home ( ) Business ( ) Other _____

No. Bedrooms 3 No. Bathrooms 2

Garbage Disposal Unit	Yes ( )	No (X)	
Auto. Dishwasher	Yes (✓)	No ( )	
Auto. Wash. Machine	Yes (✓)	No ( )	
Site Suitable	Yes (✓)	No ( )	

Lot Area 20,000ft²

Character & Porosity of Soil Clay


Percolation Rate 0-5 90 ft/day

Topography 2-4%

Depth to Water Table 4ft+

Rock or other impervious formations None Noted

_____ Basement with Plumbing _____ Basement without Plumbing ✓ No Basement

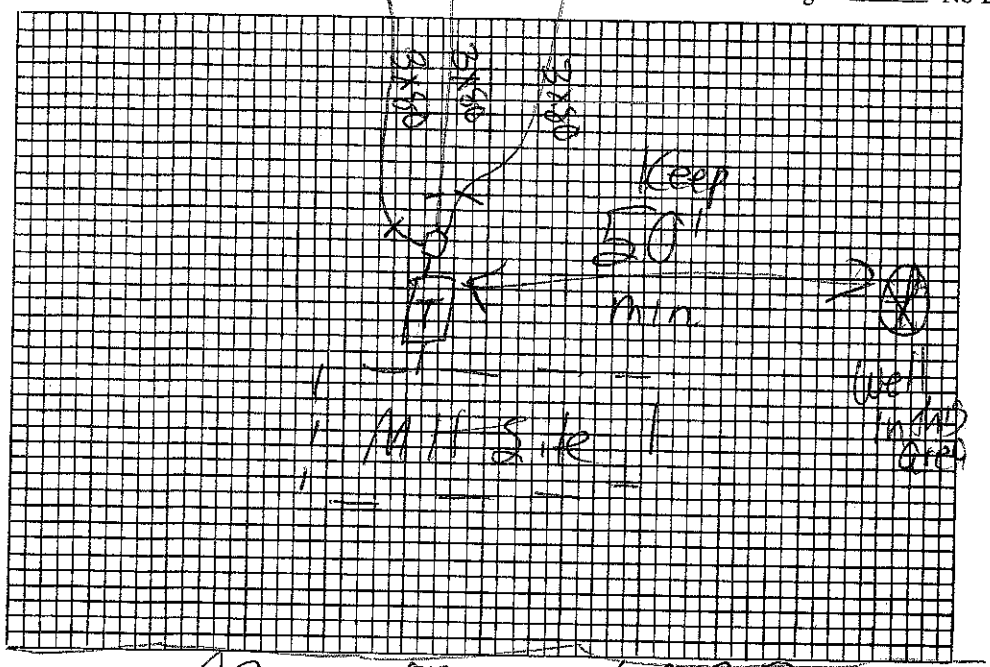

Plan of System

Marlo Loop

Size of Tank 1000 Gals.

Nitrification Field:
No. of Lines 3
Sq. Ft. 720 Linear Ft. 240
Depth of Stone in Lines 12

Water Supply: Individual (✓)
Public ( )

Installed by F.D. Ervin

I understand and agree to install septic tank system as specified on this Improvements Permit.

Signed: _____

IMPROVEMENTS PERMIT BY Fred Clemmer

COMMENTS: Keep well 50' minimum from all septic lines

CERTIFICATE OF COMPLETION BY [signature] DATE 10/19/85

EXISTING SYSTEM CHECKED BY: _____ DATE _____

CONSTRUCTION MUST COMPLY WITH ALL OTHER APPLICABLE STATE AND LOCAL REGULATIONS.

Permit is VOID if any unauthorized changes are made in installation of system and/or if any false information is supplied in making Improvements Permit.

Health Dept. Copy: White Inspection Dept. Copy: Yellow Sanitarian's Copy: Pink Owner's Copy: Gold