IREDELL COUNTY HEALTH DEPARTMENT

STATESVILLE 704-878-5305 MOORESVILLE 704-664-5281

IMPROVEMENT PERMIT / AUTHORIZATION TO CONSTRUCT / OPERATION PERMIT / EXISTING SYSTEM INSPECTION

PERMIT# 115174 PIN# 4740509673 DATE 9/8/03

OWNER OR CONTRACTOR Thomas John Development PHONE: Business 562-6247 Home

ADDRESS P.O. Box 1149 Cornelius, NC 28031

LOCATION 121 Marlo Loop Hwy 115 TL Flowerhouse Ln TL Carlyle TL Marlo Loop

SUBDIVISION Carlyle Farms BLOCK / SECTION LOT 5 LOT AREA 1.05 Acre SITE CLASS. PS DESIGN FLOW 360gpd L.T.A.R.

Septic Tank: Existing Gallons: STB Date

Pump Tank: Gallons: PT Date

Pump Make: Model Serial No.

Nitrification Field: No Fields 1 Square Feet 720 Linear Feet 240

No Lines 3@80 Trench Width Ex Max Trench Bottom Depth Gravel Depth 12"

☐ New System ☐ Repair System Type: I, II, III, IV, V, VI

System Description: Existing Gravity Conventional

Repair System Description:

Maintenance Agreement Required: ☐ Yes ☐ No

☐ House/Mod. Home ☒ Mobile Home ☐ Business ☐ Other

No. Bedrooms 3 No. Bathrooms 2 No. Employees


☐ Slab ☐ Crawl Space ☐ Basement w/plumbing ☐ Basement wo/plumbing

Water Supply: ☐ Individual ☒ Public ☐ Community

Comments:/Conditions: Existing Septic System appears to be functioning okay at time of inspection, no problems noticed. DL 33'

Comments:/Conditions: System originally installed 1986 Under Marlo Corp

INITIAL SITE SKETCH

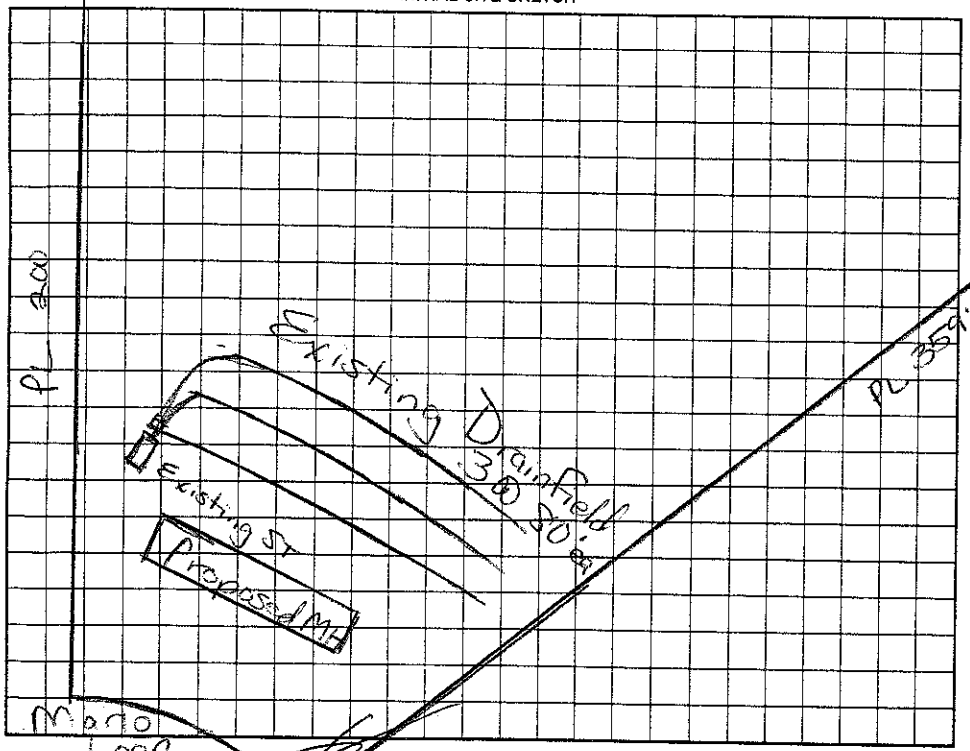

AS BUILT SKETCH

Permit can be suspended or revoked if any false information is supplied toward securing the permit/any unauthorized changes are made to the site/any unauthorized changes are made in the installation of the system. Improvement Permit with plat valid without expiration. Improvement Permit with site plan valid for sixty months. Authorization to Construct is valid for a period equal to that of Improvement Permit – not to exceed sixty months.

Signed: date

Improvement Permit by: Marina H. Dotson RS date 9/8/03

Authorization to Construct by: date

Installed by:

Operation Permit by: date

Existing System Inspection by: Marina H. Dotson RS date 9/8/03

HEALTH DEPT. COPY: WHITE OWNER COPY (FINAL): YELLOW OWNER COPY (INITIAL): PINK