IREDELL COUNTY HEALTH DEPARTMENT

STATESVILLE 704-878-5305 $130 MOORESVILLE 704-664-5281

IMPROVEMENT PERMIT / AUTHORIZATION TO CONSTRUCT / OPERATION PERMIT / EXISTING SYSTEM INSPECTION

PERMIT# 118721 PIN# 4740-50-7957 DATE 2/24/04

OWNER OR CONTRACTOR Oakwood Homes PHONE: Business 704-528-9449 Home

ADDRESS 1018 Charlotte Hwy Troutman NC 28166

LOCATION 115/21 N, TL Fiberhouse, TL Carlyle, on LT

SUBDIVISION Carlyle Farms BLOCK / SECTION LOT 4 LOT AREA 2.11 Ac SITE CLASS. FS DESIGN FLOW 600 L.T.A.R. 0.25 I/C 3R

Septic Tank: 1500 Gallons: STB 1012 Date 1/27/04

Pump Tank: Gallons: PT Date

Pump Make: Model Serial No.

Nitrification Field: No Fields 1 Square Feet 1800 Linear Feet 600

No Lines 4 or 5 Trench Width 36" Max Trench Bottom Depth 24" Gravel Depth ---

☒ New System ☐ Repair System Type: I, II, (III), IV, V, VI

System Description: Gravity 25% Reduction

Repair System Description: Pump 25% Reduction

Maintenance Agreement Required: ☐ Yes ☒ No

☒ House/Mod. Home ☐ Mobile Home ☐ Business ☐ Other

No. Bedrooms 5 No. Bathrooms 3 No. Employees

Water Supply: ☒ Individual ☐ Public ☐ Community


☐ Slab ☒ Crawl Space ☐ Basement w/plumbing ☐ Basement wo/plumbing

Comments:/Conditions:


756.24'

Comments:/Conditions:

INITIAL SITE SKETCH

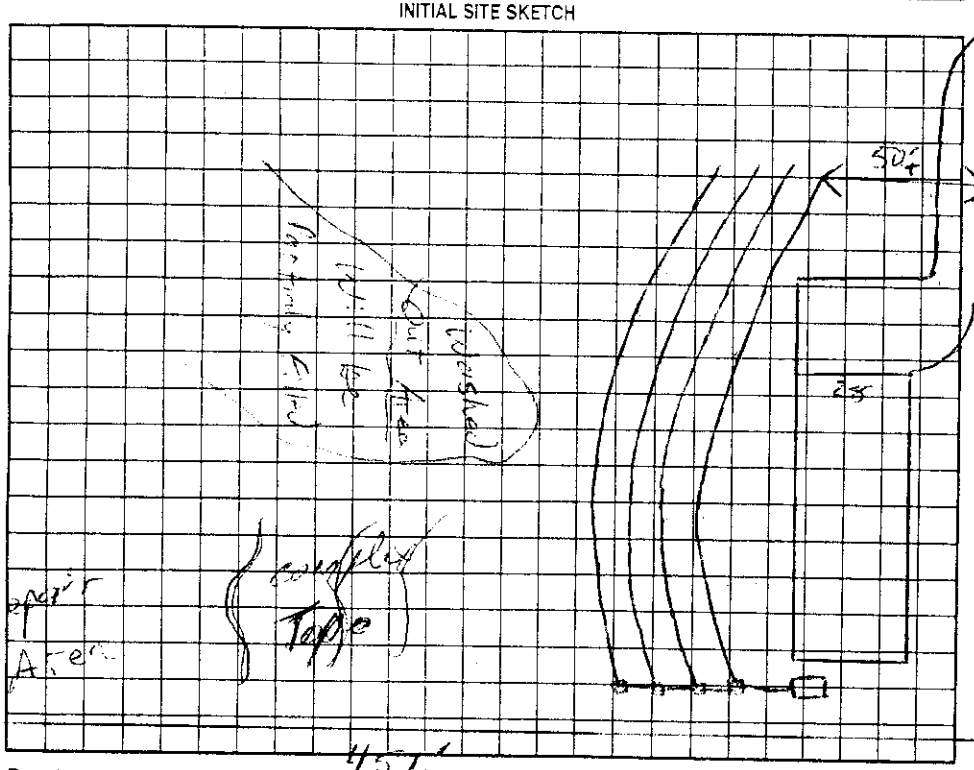

AS BUILT SKETCH

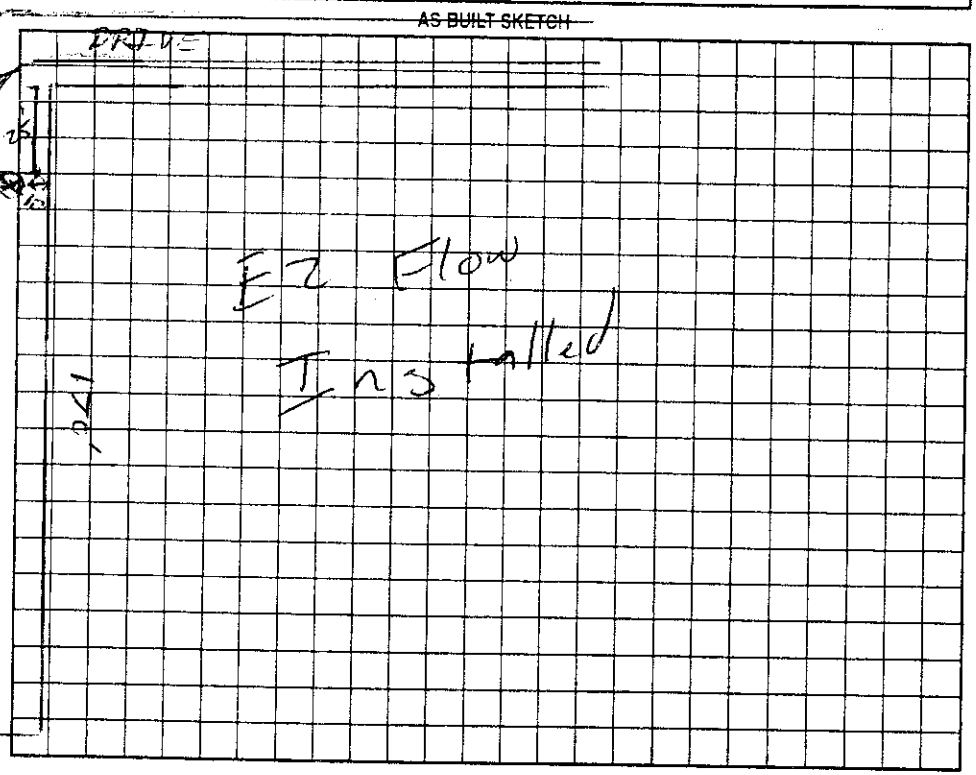

Permit can be suspended or revoked if any false information is supplied toward securing the permit/any unauthorized changes are made to the site/any unauthorized changes are made in the installation of the system. Improvement Permit with plat valid without expiration. Improvement Permit with site plan valid for sixty months. Authorization to Construct is valid for a period equal to that of Improvement Permit – not to exceed sixty months.

Signed: date

Improvement Permit by: RS date 2/24/04

Authorization to Construct by: RS date 2/24/04

Installed by: Craig Thompson

Operation Permit by: RS date 7/9/04

Existing System Inspection by: date

HEALTH DEPT. COPY: WHITE OWNER COPY (FINAL): YELLOW OWNER COPY (INITIAL): PINK