Type IV -06

$225.00 Pd.

IREDELL COUNTY HEALTH DEPARTMENT

STATESVILLE 704-878-5305 MOORESVILLE 704-664-5281

IMPROVEMENT PERMIT / AUTHORIZATION TO CONSTRUCT / OPERATION PERMIT / EXISTING SYSTEM INSPECTION

PERMIT# 135012 PIN# 4740 51 0025 DATE May 18, 2006

OWNER OR APPLICANT Corinthian Bldrs. PHONE: Business 704 400 1258 Home

ADDRESS P.O. Box 3421 Mooresville NC 28117

LOCATION 115-21 N TL Flower Home Loop TL Carlyle TR Farmdale TL Grafton 1st house on left - corner lot

SUBDIVISION Carlyle Farms BLOCK / SECTION 3 LOT 25 LOT AREA ± .707 Ac SITE CLASS. PS DESIGN FLOW 360 gpd L.T.A.R. ± .25

Septic Tank: 1000 Gallons; STB 780 Date 4-10-06

Pump Tank: 1000 Gallons; PT 37 Date 4-24-06

Pump Make: MYERS Model ME-5a5 Serial No.

Nitrification Field: No Fields 1 Square Feet 747 Linear Feet 249 *

No Lines 4 Trench Width * 36" Max Trench Bottom Depth 36"

☑ New System ☐ Repair ☐ Expansion System Type: I II III IV V VI

System Description: LP PPBPS

Repair System Description: LP PPBPS

Maintenance Agreement Required: ☒ Yes ☐ No

☒ House/Mod. Home ☐ Mobile Home ☐ Business ☐ Other

No. Bedrooms 3 No. Persons No. Employees

Water Supply: ☒ Individual ☐ Public ☐ Community

Gravel Depth N/A ☐ Gravity ☒ Pressure ☐ Slab ☒ Crawl Space ☐ Basement w/plumbing ☐ Basement wo/plumbing

Comments:/Conditions:

* Per Plan Specs

1st Line filter required in pump tank


Comments:/Conditions:

Septic tank w/ marker

INITIAL SITE SKETCH

SEE PLAN from Rollins Soil & Env. Services

AS BUILT SKETCH 57 panels

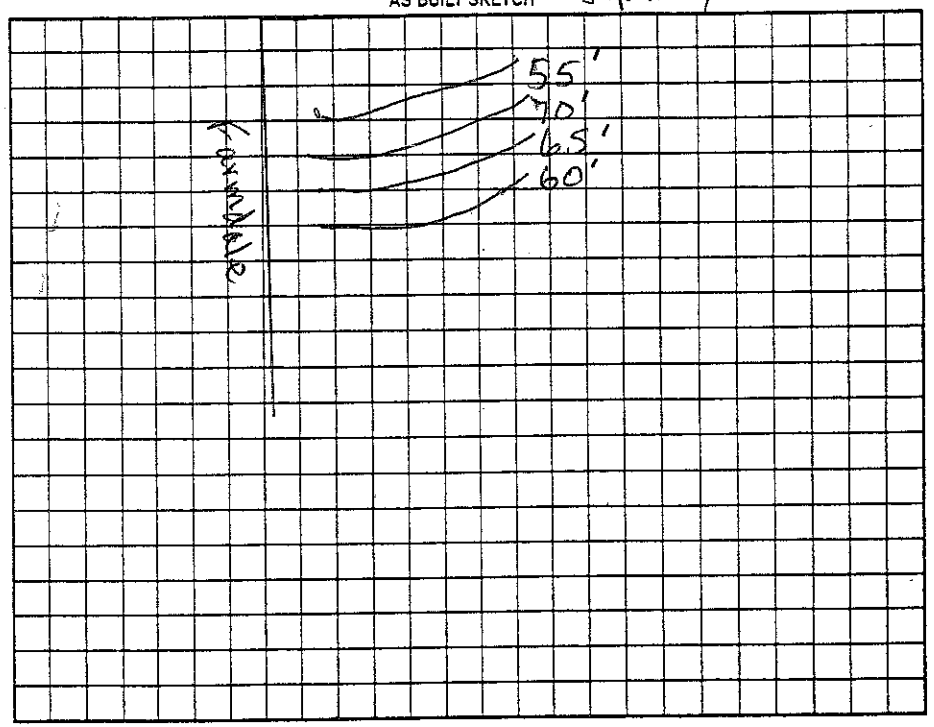

Permit can be suspended or revoked if any false information is supplied toward securing the permit/any unauthorized changes are made to the site/any unauthorized changes are made in the installation of the system. Improvement Permit with plat valid without expiration ☐ Improvement Permit with site plan valid for sixty months ☒ Authorization to Construct is valid for a period equal to that of Improvement Permit – not to exceed sixty months.

Signed: Melissa Mikeal date 5-18-06

Improvement Permit by: [signature] date 5-18-06


Authorization to Construct by: [signature] date 5-18-06

Installed by: Corinthian Builders

Operation Permit by: Wendy Spencer R.S. date 7/21/06

Existing System Inspection by: date

HEALTH DEPT. COPY: WHITE OWNER COPY (FINAL): YELLOW OWNER COPY (INITIAL): PINK

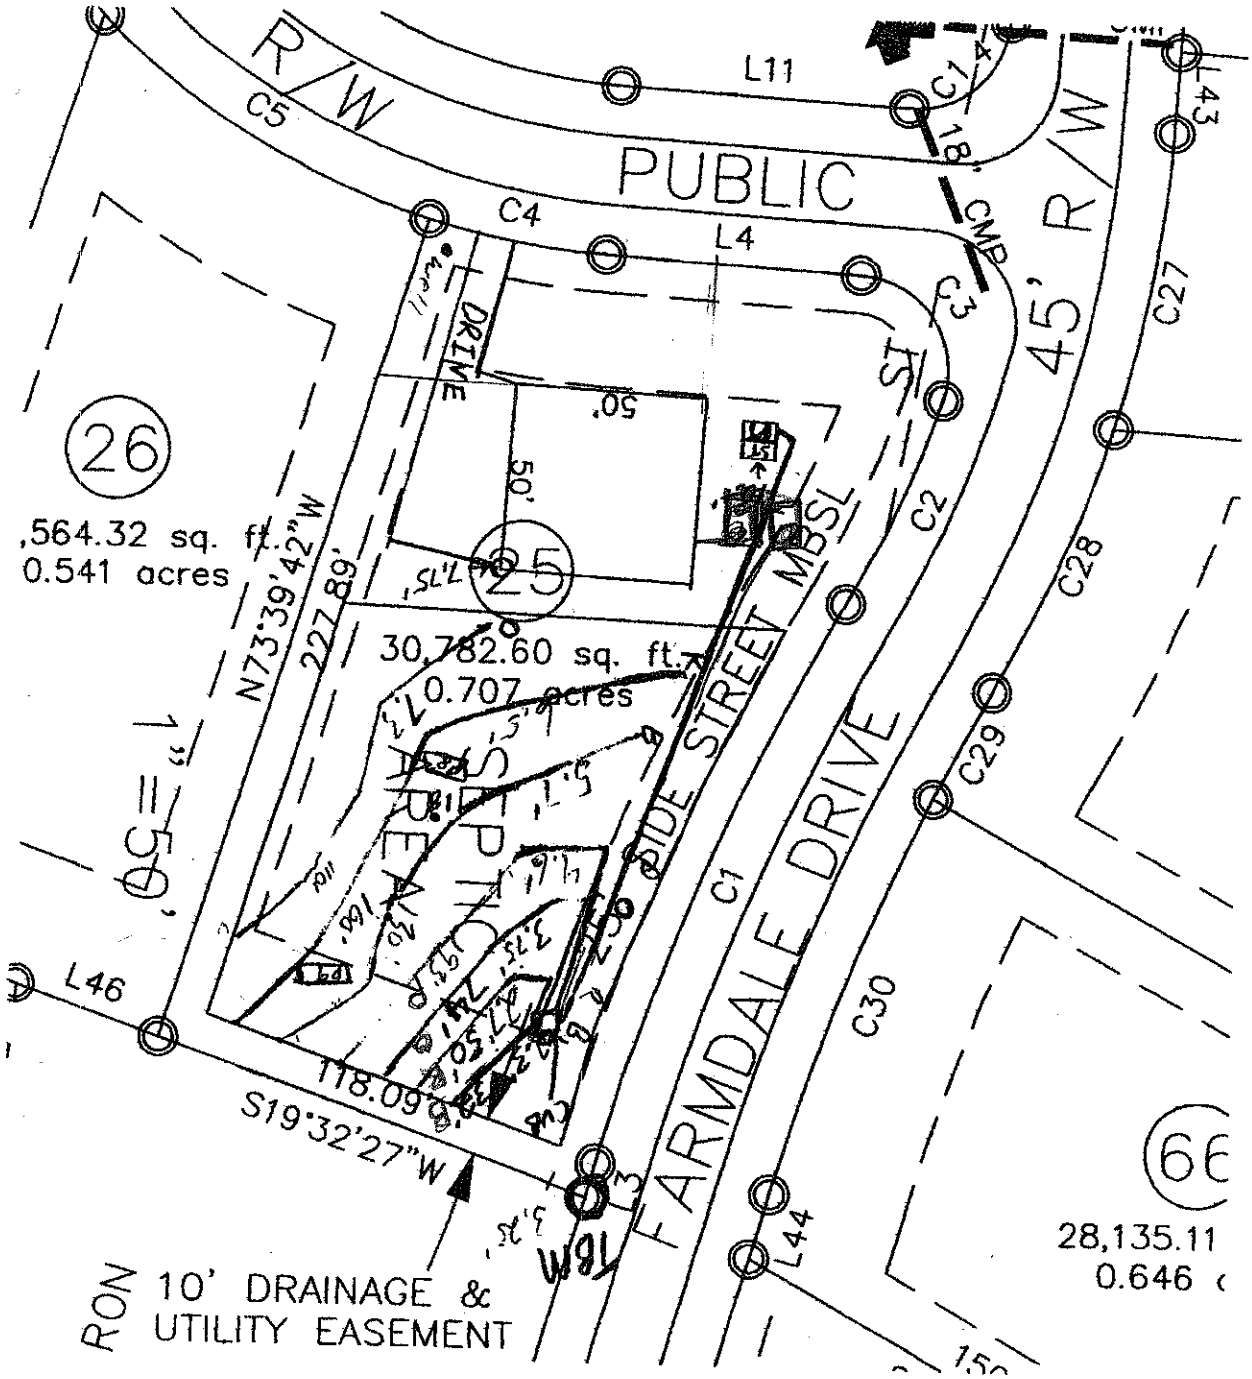
R/W
PUBLIC
45' R/W
FARMDALE DRIVE
SIDE STREET MBSL
DRIVE
ST
26
25
,564.32 sq. ft.
0.541 acres
30,782.60 sq. ft.
0.707 acres
N73°39'42"W
227.89'
118.09'
S19°32'27"W
10' DRAINAGE &
UTILITY EASEMENT
28,135.11
0.646
L11
L4
L46
L44
C1
C2
C3
C4
C5
C27
C28
C29
C30