704 - 400 - 152

2:30

IREDELL COUNTY HEALTH DEPARTMENT

STATESVILLE 704-878-5305 MOORESVILLE 704-664-5281

IMPROVEMENT PERMIT / AUTHORIZATION TO CONSTRUCT / OPERATION PERMIT / EXISTING SYSTEM INSPECTION

PERMIT# 134181 PIN# 4740 51 0390 DATE 3/21/06

OWNER OR APPLICANT Corinthian Bldrs. PHONE: Business 704-400-1258 Home

ADDRESS PO Box 3241 Mooresville, NC. 28117

LOCATION I15-21 N TL 1st FH Loop TL CARLYLE RD. TR FARMDALE LN. ON (R) BEFORE GRAFTON PL

SUBDIVISION CARLYLE FARMS BLOCK / SECTION LOT 65 LOT AREA .871 SITE CLASS. PS DESIGN FLOW 480 GPD L.T.A.R. .3

Septic Tank: 1000 Gallons; STB 780 Date 4-6-06
Pump Tank: 1000 Gallons; PT 32 Date 3-1-06
Pump Make: Myers Model ME-50S Serial No 25325000
Nitrification Field: No Fields 1 Square Feet 1200 Linear Feet 400
No Lines 4@100 Trench Width 3' Max Trench Bottom Depth 3'

[X] New System [ ] Repair [ ] Expansion System Type: I II [III] IV V VI
System Description: PM → 25% REDUCED
Repair System Description: SAME
Maintenance Agreement Required: [ ] Yes [ ] No


[X] House/Mod. Home No. Bedrooms 4
[ ] Mobile Home No. Persons 4
[ ] Business No. Employees
[ ] Other

Water Supply: [X] Individual [ ] Public [ ] Community

Gravel Depth No [ ] Gravity [X] Pressure [ ] Slab [X] Crawl Space [ ] Basement w/plumbing [ ] Basement wo/plumbing


Comments:/Conditions:

INITIAL SITE SKETCH

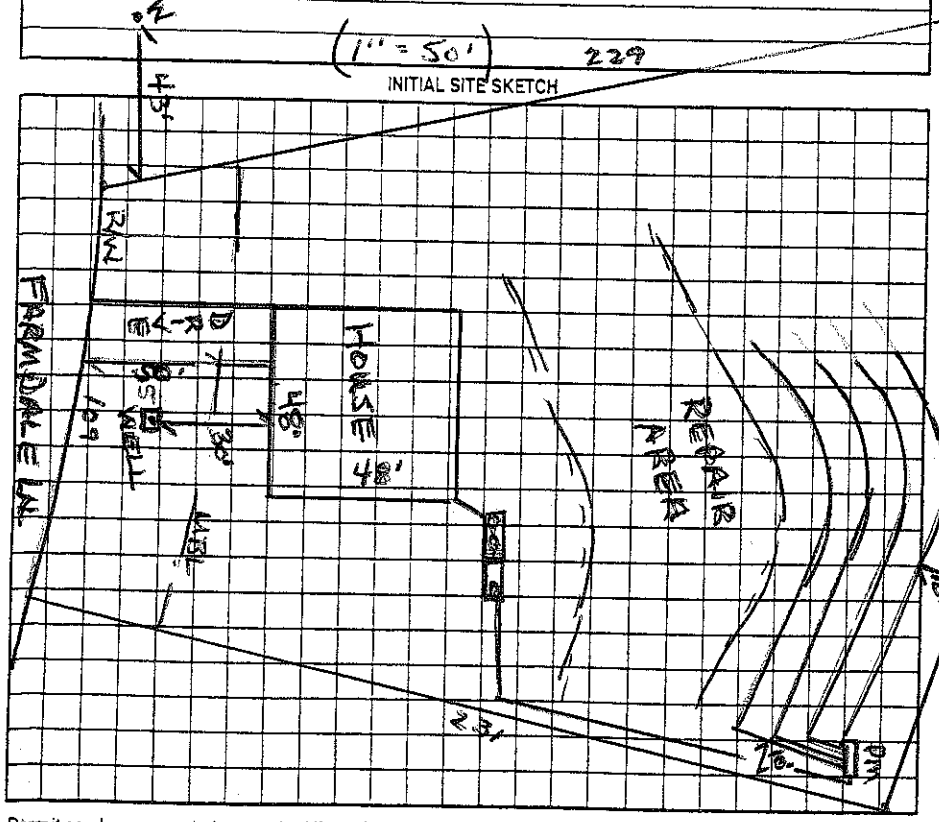

Comments:/Conditions: Checked tanks & lines 6/23/06
Used Quick 4 for Drainfield

AS BUILT SKETCH

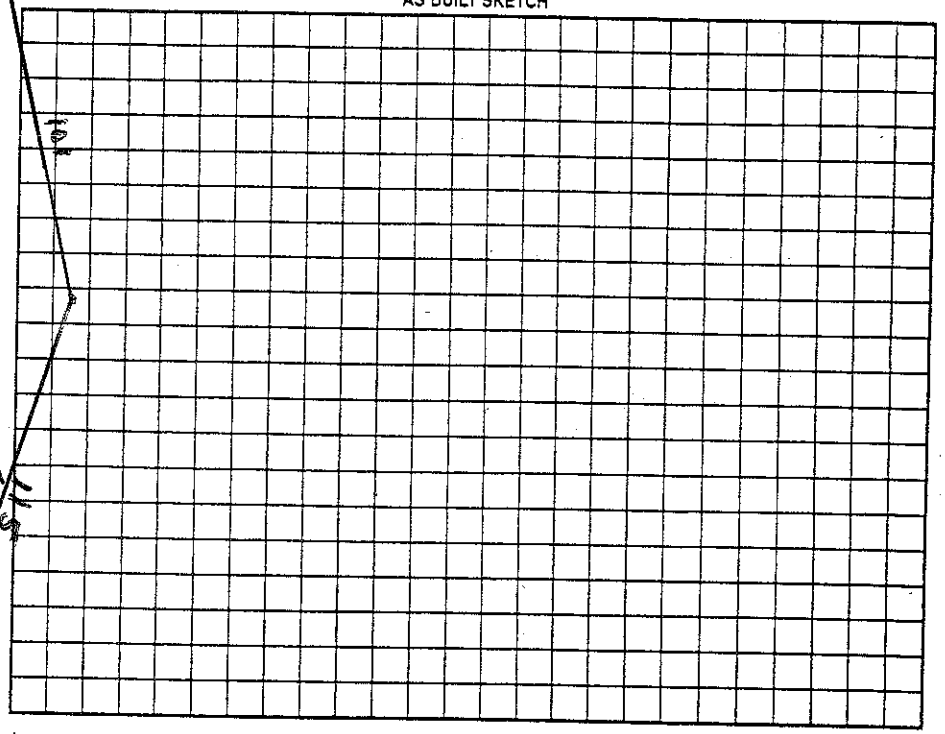

Permit can be suspended or revoked if any false information is supplied toward securing the permit/any unauthorized changes are made to the site/any unauthorized changes are made in the installation of the system. Improvement Permit with plat valid without expiration. [ ] Improvement Permit with site plan valid for sixty months [ ] Authorization to Construct is valid for a period equal to that of Improvement Permit – not to exceed sixty months.

Signed: X date 5-4-06

Improvement Permit by: Wesley Sparks RS date 3/21/06

Authorization to Construct by: Wesley Sparks RS date 3/21/06

Installed by: Corinthian Builders

Operation Permit by: RS date 8/23/06

Existing System Inspection by: date

HEALTH DEPT. COPY: WHITE OWNER COPY (FINAL): YELLOW OWNER COPY (INITIAL): PINK