IREDELL COUNTY HEALTH DEPARTMENT

STATESVILLE 704-878-5305 MOORESVILLE 704-664-5281

IMPROVEMENT PERMIT / AUTHORIZATION TO CONSTRUCT / OPERATION PERMIT / EXISTING SYSTEM INSPECTION

PERMIT# 135740 PIN# 4740 51 0807 DATE 6/17/06

OWNER OR APPLICANT Corinthian Bldrs PHONE: Business Home

ADDRESS Po Box 990 Denver NC 28037

LOCATION 115N, TL Flowerhouse, TL Carlyle, TR Farmdale, TR Holmfield, TR Lorain, on LT

SUBDIVISION Carlyle Farms BLOCK / SECTION LOT 48 LOT AREA 0.773 AC SITE CLASS. B3 DESIGN FLOW 360 L.T.A.R. 0.3

Septic Tank: 1000 Gallons; STB 55 Date 8/2/06

Pump Tank: Gallons; PT Date

Pump Make: Model Serial No.

Nitrification Field: No Fields 1 Square Feet 1200 Linear Feet 400

No Lines ~~5~~ 6 Trench Width 36" Max Trench Bottom Depth 36" Gravel Depth 12" ☒ Gravity ☐ Pressure

☒ New System ☐ Repair ☐ Expansion System Type: I (II) III IV V VI

System Description: Conventional

Repair System Description: 25% Reduction

Maintenance Agreement Required: ☐ Yes ☒ No

☒ House/Mod. Home No. Bedrooms 3

☐ Mobile Home No. Persons

☐ Business No. Employees

☐ Other

Water Supply: ☒ Individual ☐ Public ☐ Community


☐ Slab ☒ Crawl Space ☐ Basement w/plumbing ☐ Basement wo/plumbing

Comments/Conditions: (Lot 60-75') Inspections Q4


Comments/Conditions: 75, 68, 68, 60

1"=50'

INITIAL SITE SKETCH

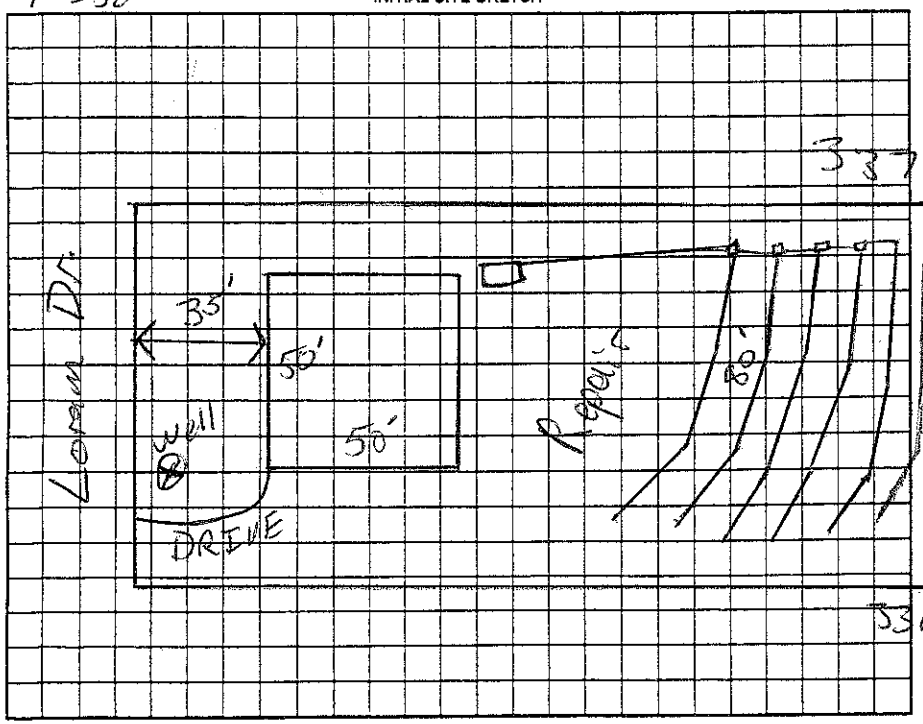

AS BUILT SKETCH

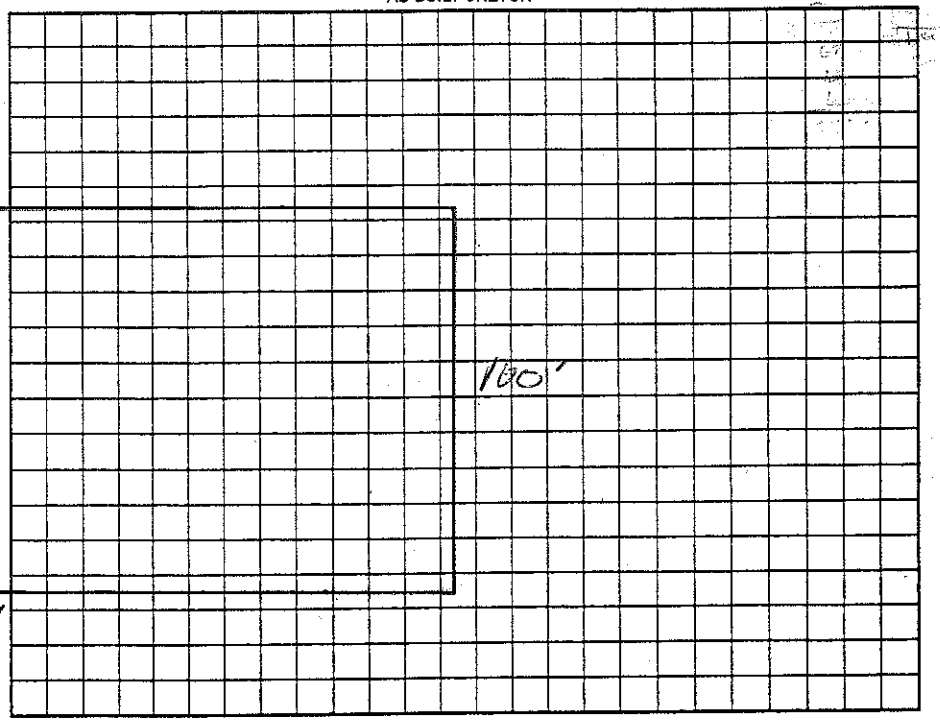

Permit can be suspended or revoked if any false information is supplied toward securing the permit/any unauthorized changes are made to the site/any unauthorized changes are made in the installation of the system. Improvement Permit with plat valid without expiration ☐ Improvement Permit with site plan valid for sixty months ☐ Authorization to Construct is valid for a period equal to that of Improvement Permit – not to exceed sixty months.

Signed: Melissa Neal date 6-19-06 Installed by: Corinthian Dev.

Improvement Permit by: RS date 6/17/06 Operation Permit by: Wesley Sparks RS. date 10/26/06

Authorization to Construct by: RS date 6/17/06 Existing System Inspection by: date

HEALTH DEPT. COPY: WHITE OWNER COPY (FINAL): YELLOW OWNER COPY (INITIAL): PINK