IREDELL COUNTY HEALTH DEPARTMENT

STATESVILLE 704-878-5305 MOORESVILLE 704-664-5281

IMPROVEMENT PERMIT / AUTHORIZATION TO CONSTRUCT / OPERATION PERMIT / EXISTING SYSTEM INSPECTION

PERMIT# 133057 PIN# 4740 51 1502. DATE 1/3/06

OWNER OR CONTRACTOR Corinthian Builders PHONE: Business 704-400-1258 Home

ADDRESS PO Box 3421 Mooresville NC 28115

LOCATION 115 N, TL Flowerhouse, TL Carlyle, TR Farmdale, TR Holmfield, TR Logan, on Rt

SUBDIVISION Carlyle Farms BLOCK / SECTION LOT 56 LOT AREA ~0.5AC SITE CLASS A5 DESIGN FLOW 360 L.T.A.R. 0.3

Septic Tank: 1000 Gallons; STB 786 Date 12/7/05

Pump Tank: 1000 Gallons; PT 32 Date 9/20/85

Pump Make: Myers Model ME50 Serial No.

Nitrification Field: No Fields 1 Square Feet 900 Linear Feet 300

No Lines 4@75' Trench Width 36" Max Trench Bottom Depth 36" Gravel Depth —

☒ New System ☐ Repair System Type: I, II, III, IV, V, VI

System Description: Pump 25% Reduction

Repair System Description: Same

Maintenance Agreement Required: ☐ Yes ☒ No

☒ House/Mod. Home No. Bedrooms 3

☐ Mobile Home No. Bathrooms

☐ Business No. Employees

☐ Other

☐ Slab ☒ Crawl Space ☐ Basement w/plumbing ☐ Basement wo/plumbing


Water Supply: ☒ Individual ☐ Public ☐ Community

Comments:/Conditions:


Comments:/Conditions:

1"=40'

INITIAL SITE SKETCH

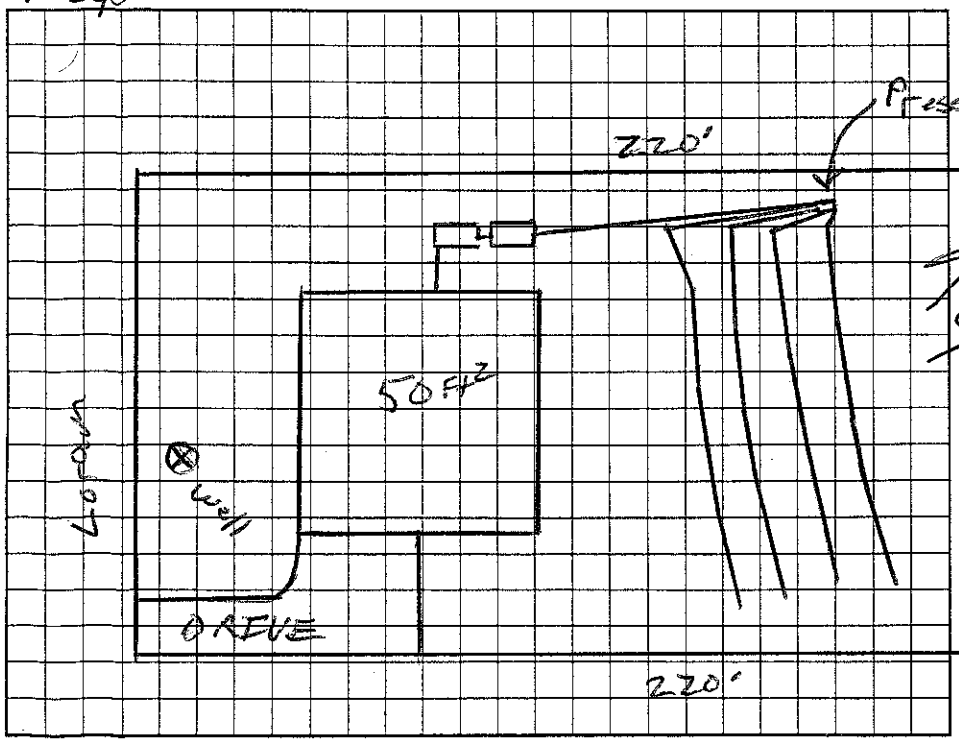

AS BUILT SKETCH

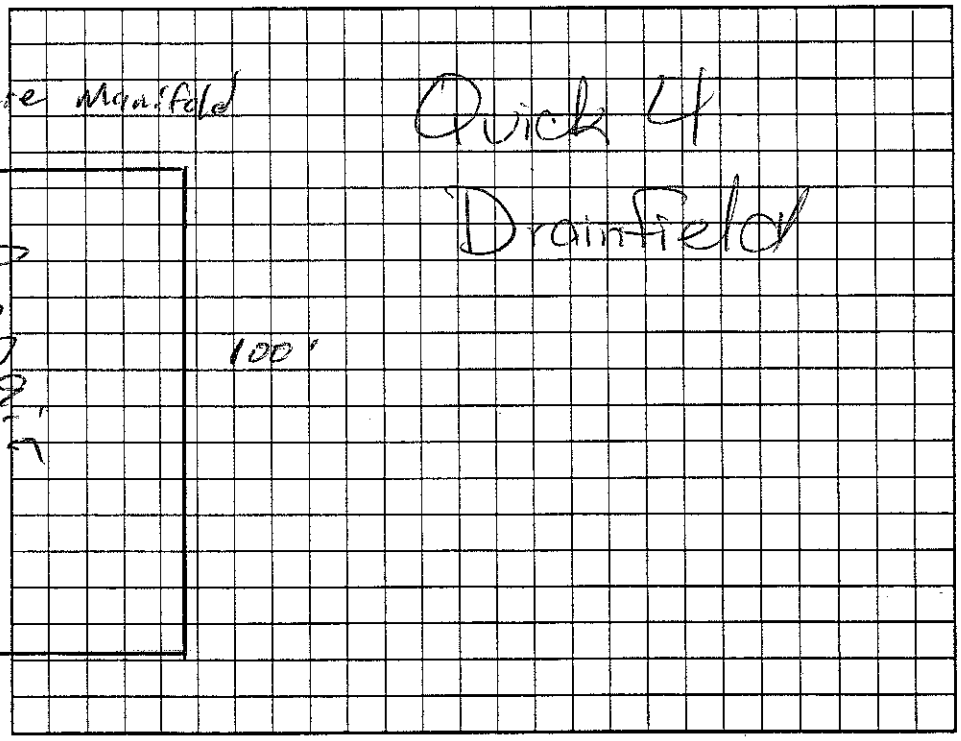

Permit can be suspended or revoked if any false information is supplied toward securing the permit/any unauthorized changes are made to the site/any unauthorized changes are made in the installation of the system. Improvement Permit with plat valid without expiration. Improvement Permit with site plan valid for sixty months. Authorization to Construct is valid for a period equal to that of Improvement Permit – not to exceed sixty months.

Signed: date 1-24-06 Installed by: Corinthian

Improvement Permit by: RS date 1/3/06 Operation Permit by: Marcia H. Dolan date 4/27/06

Authorization to Construct by: RS date 1/25/06 Existing System Inspection by: date

HEALTH DEPT. COPY: WHITE OWNER COPY (FINAL): YELLOW OWNER COPY (INITIAL): PINK