550.00

IREDELL COUNTY HEALTH DEPARTMENT

STATESVILLE 704-878-5305 MOORESVILLE 704-664-5281

IMPROVEMENT PERMIT / AUTHORIZATION TO CONSTRUCT / OPERATION PERMIT / EXISTING SYSTEM INSPECTION

PERMIT# 134178 PIN# 4740 51 1592 DATE 3/15/06

OWNER OR APPLICANT Corinthian Bldrs PHONE: Business 704 400 1258 Home

ADDRESS PO Box 3241 Mooresville NC 28117

LOCATION 115N, TL Flowerhouse, TL Carlyle, TR Farmdale, TR Holm Field, TR Loram at end on Rt

SUBDIVISION Carlyle Farms BLOCK / SECTION LOT 55 LOT AREA 0.554 AC SITE CLASS. PS DESIGN FLOW 360 L.T.A.R. 0.3

Septic Tank: 1000 Gallons; STB 786 Date 3/14/06
Pump Tank: 1000 Gallons; PT 32 Date 4/10/06
Pump Make: MYERS Model ME-50S Serial No. 253255D057
Nitrification Field: No Fields 1 Square Feet 900 Linear Feet 300
No Lines 4@75' Trench Width 36" Max Trench Bottom Depth 36" Gravel Depth —

☒ New System ☐ Repair ☐ Expansion System Type: I II (III) IV V VI
System Description: 25% Reduction
Repair System Description: Same
Maintenance Agreement Required: ☐ Yes ☒ No
☐ Gravity ☒ Pressure ☐ Slab ☒ Crawl Space ☐ Basement w/plumbing ☐ Basement wo/plumbing

☒ House/Mod. Home ☐ Mobile Home ☐ Business ☐ Other
No. Bedrooms 3 No. Persons No. Employees


Water Supply: ☒ Individual ☐ Public ☐ Community

Comments:/Conditions:

Comments:/Conditions: Any Heater installed TANKS, PUMP, DRAINFIELD

INITIAL SITE SKETCH

AS BUILT SKETCH

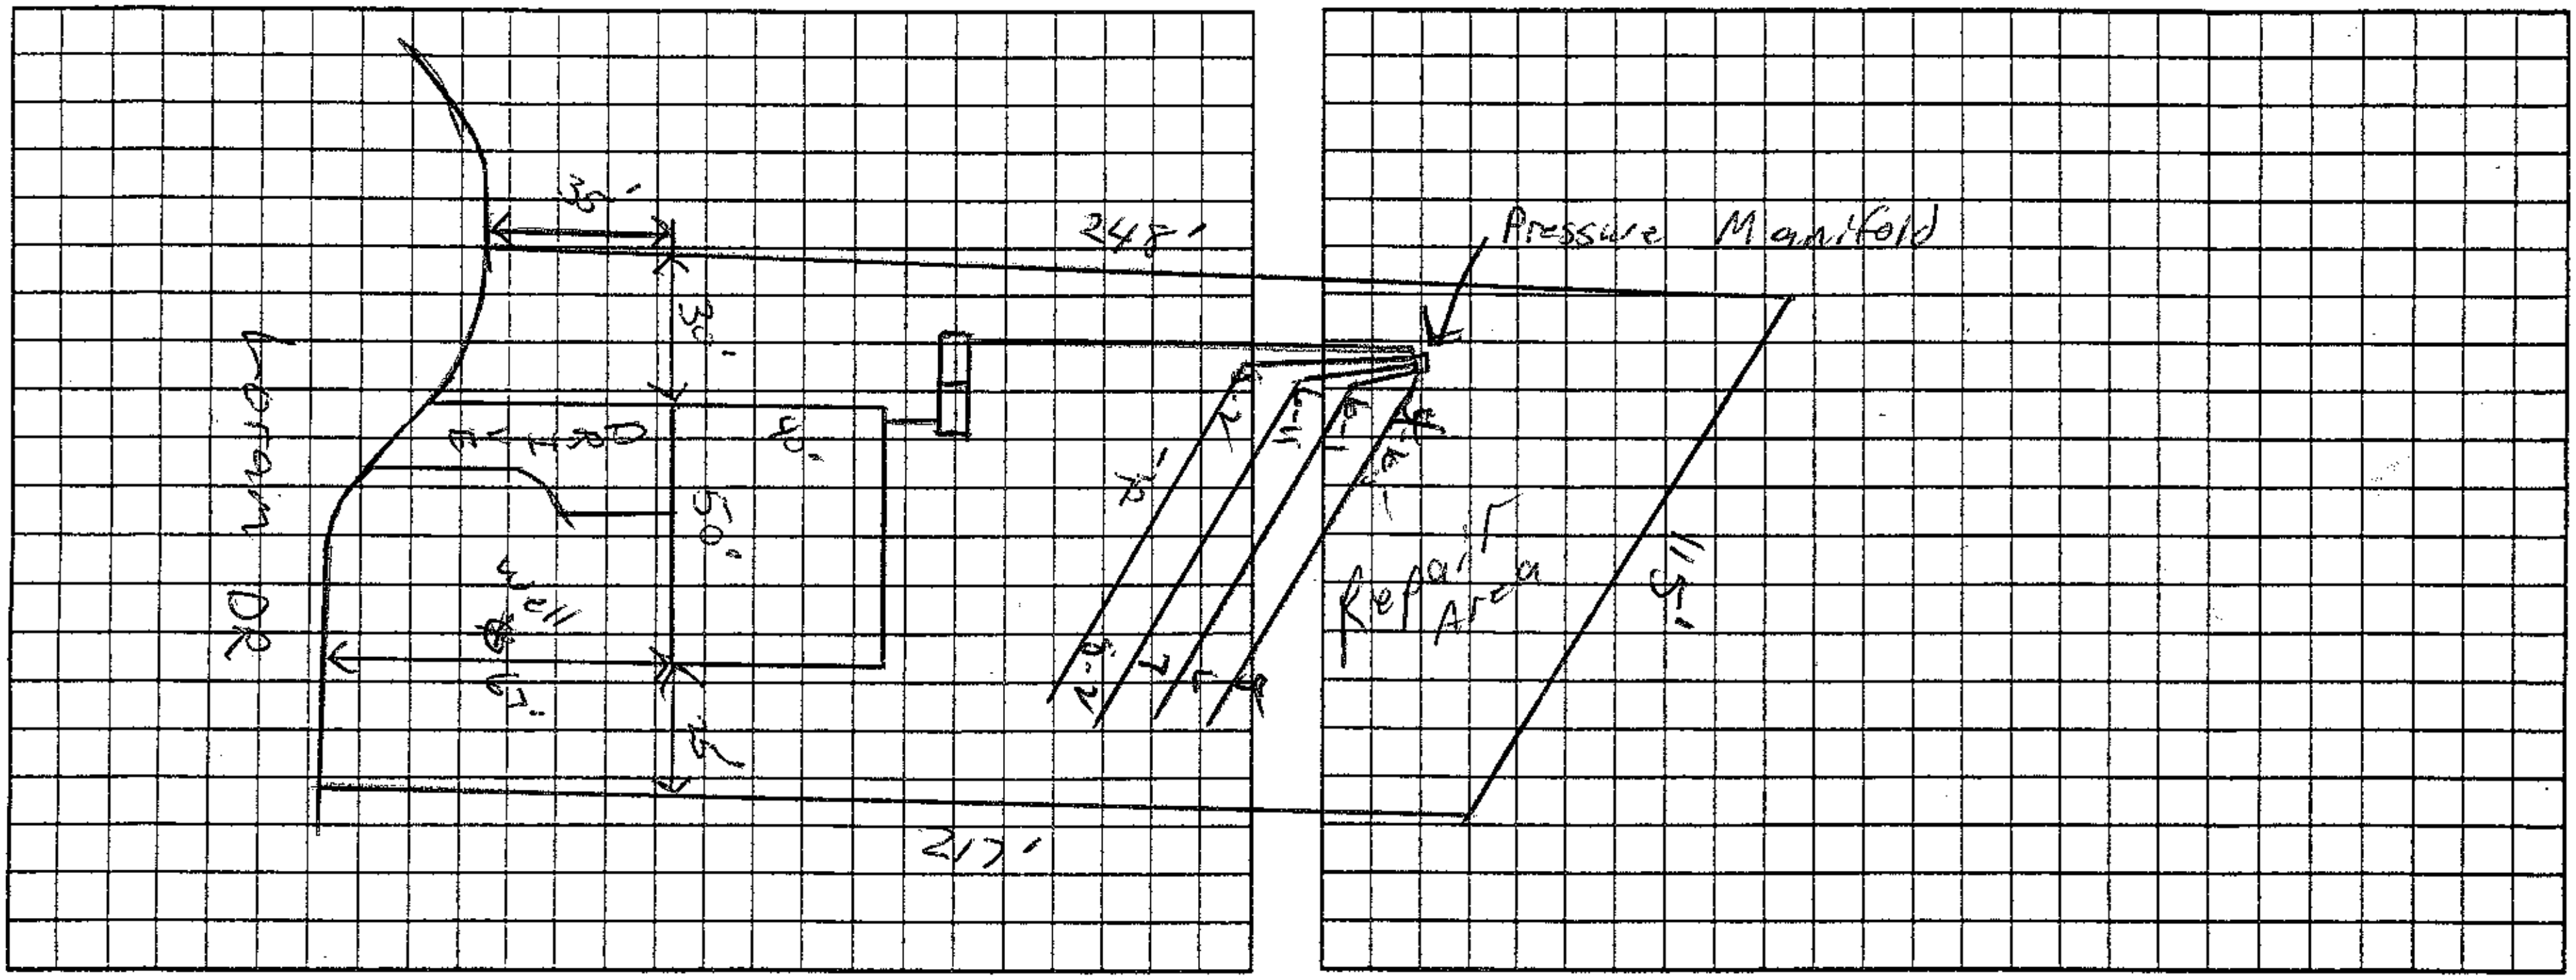

Permit can be suspended or revoked if any false information is supplied toward securing the permit/any unauthorized changes are made to the site/any unauthorized changes are made in the installation of the system. Improvement Permit with plat valid without expiration ☐ Improvement Permit with site plan valid for sixty months ☒ Authorization to Construct is valid for a period equal to that of Improvement Permit – not to exceed sixty months.

Signed: date 3-20-06 Installed by: Corinthian Builders

Improvement Permit by: RS date 3/15/06 Operation Permit by: date 7-20-06

Authorization to Construct by: RS date 3/15/06 Existing System Inspection by: date

HEALTH DEPT. COPY: WHITE OWNER COPY (FINAL): YELLOW OWNER COPY (INITIAL): PINK