IREDELL COUNTY HEALTH DEPARTMENT

STATESVILLE 704-878-5305 MOORESVILLE 704-664-5281

406

IMPROVEMENT PERMIT / AUTHORIZATION TO CONSTRUCT / OPERATION PERMIT / EXISTING SYSTEM INSPECTION

PERMIT# 103606 PIN# 4740-51-3164 DATE 12/19/01

OWNER OR CONTRACTOR Morningstar Builders PHONE: Business 704-883-7795 Home

ADDRESS 2027 Shelton Ave. Statesville NC 28677

LOCATION 115N, TL Flowerhouse, TL Carlyle on Rt

SUBDIVISION Carlyle Farms BLOCK / SECTION 2 LOT 10 LOT AREA 0.554c SITE CLASS. PS DESIGN FLOW 360 L.T.A.R. 0.3

Septic Tank: 1000 Gallons; STB 1012 Date 5/15/01
Pump Tank: Gallons; PT Date
Pump Make: Model Serial No.
Nitrification Field: No Fields 1 Square Feet 1200 Linear Feet 400
No Lines 5@80' Trench Width 36" Max Trench Bottom Depth 36" Gravel Depth 12"

☒ New System ☐ Repair System Type: I (II) III. IV. V. VI
System Description: Gravity Conventional
Repair System Description: Pump 25% Red.
Maintenance Agreement Required: ☐ Yes ☒ No


☐ House/Mod. Home No. Bedrooms 3
☒ Mobile Home No. Bathrooms 2
☐ Business No. Employees
☐ Other
☐ Slab ☒ Crawl Space ☐ Basement w/plumbing ☐ Basement wo/plumbing

Water Supply: ☒ Individual ☐ Public ☐ Community

Comments:/Conditions: Install Lines on Contour - Keep well maximum distance from Septic System 50' Minimum.

Comments:/Conditions:

INITIAL SITE SKETCH

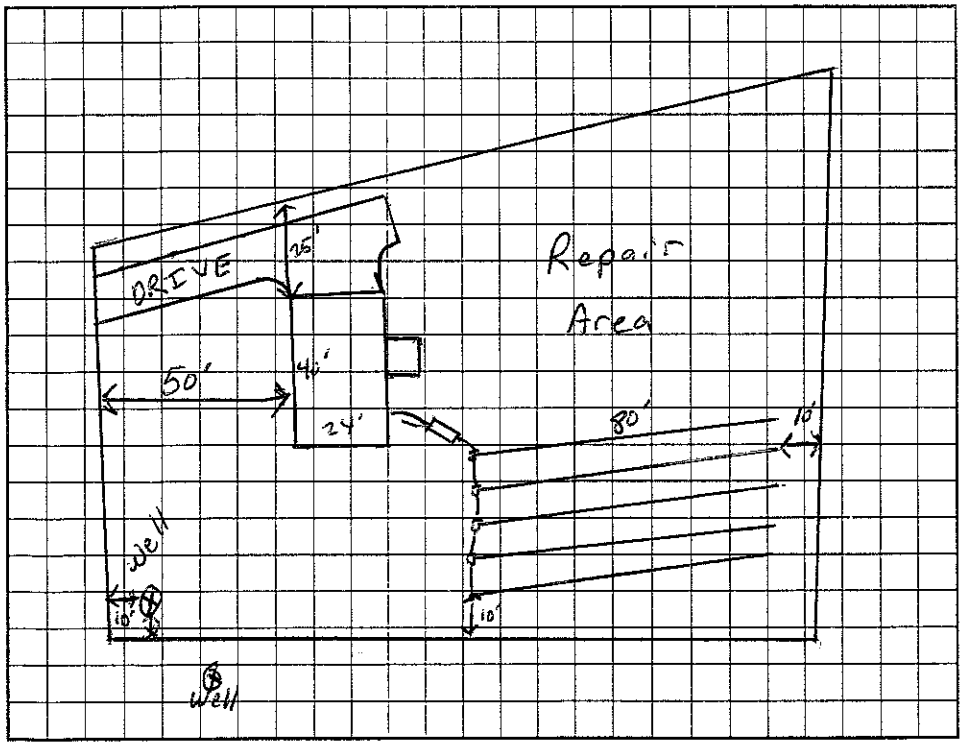

AS BUILT SKETCH

Permit can be suspended or revoked if any false information is supplied toward securing the permit/any unauthorized changes are made to the site/any unauthorized changes are made in the installation of the system. Improvement Permit with plat valid without expiration. Improvement Permit with site plan valid for sixty months. Authorization to Construct is valid for a period equal to that of Improvement Permit – not to exceed sixty months.

Signed: Heidi Cox date 12/19/01

Improvement Permit by: RST date 12/19/01

Authorization to Construct by: RST date 12/19/01

Installed by: Tommy Frye

Operation Permit by: RS date 12/27/01

Existing System Inspection by: date

HEALTH DEPT. COPY: WHITE OWNER COPY (FINAL): YELLOW OWNER COPY (INITIAL): PINK