IREDELL COUNTY HEALTH DEPARTMENT

STATESVILLE 704-878-5305 MOORESVILLE 704-664-5281

IMPROVEMENT PERMIT / AUTHORIZATION TO CONSTRUCT / OPERATION PERMIT / EXISTING SYSTEM INSPECTION

PERMIT# 135008 PIN# 4740 51 3436 DATE May 18, 2006

OWNER OR APPLICANT Corinthian Bldrs. PHONE: Business _____ Home _____

ADDRESS P.O. Box 3421, Mooresville, N.C. 28117

LOCATION I-77 N to exit 36 (Mooresville) I-77 N to Flower House Loop TL Carlyle TR Farmdale TR Holmfield TR Lorann At end on right

SUBDIVISION Carlyle Farms BLOCK / SECTION _____ LOT 54 LOT AREA .954 ac SITE CLASS. B DESIGN FLOW 360 gpd L.T.A.R. .275

Septic Tank: 1000 Gallons: STB 786 Date 5/26/06
Pump Tank: 1000 Gallons: PT 32 Date 4/11/06
Pump Make: _____ Model _____ Serial No. _____
Nitrification Field: No Fields 1 Square Feet 984 Linear Feet 328
No Lines 4 Trench Width 36" Max Trench Bottom Depth 36"

[X] New System [ ] Repair [ ] Expansion System Type: I II III IV V VI
System Description: pm 25% Reduction
Repair System Description: LS PPBPS
Maintenance Agreement Required: [ ] Yes [X] No

[X] House/Mod. Home No. Bedrooms 3
[ ] Mobile Home No. Persons ____
[ ] Business No. Employees ____
[ ] Other _____

Water Supply: [X] Individual [ ] Public [ ] Community

Gravel Depth N/A [ ] Gravity [X] Pressure [ ] Slab [X] Crawl Space [ ] Basement w/plumbing [ ] Basement wo/plumbing

Comments:/Conditions:

Comments:/Conditions:

INITIAL SITE SKETCH

SEE Plan From Rollins Soil & Env. Services

AS BUILT SKETCH

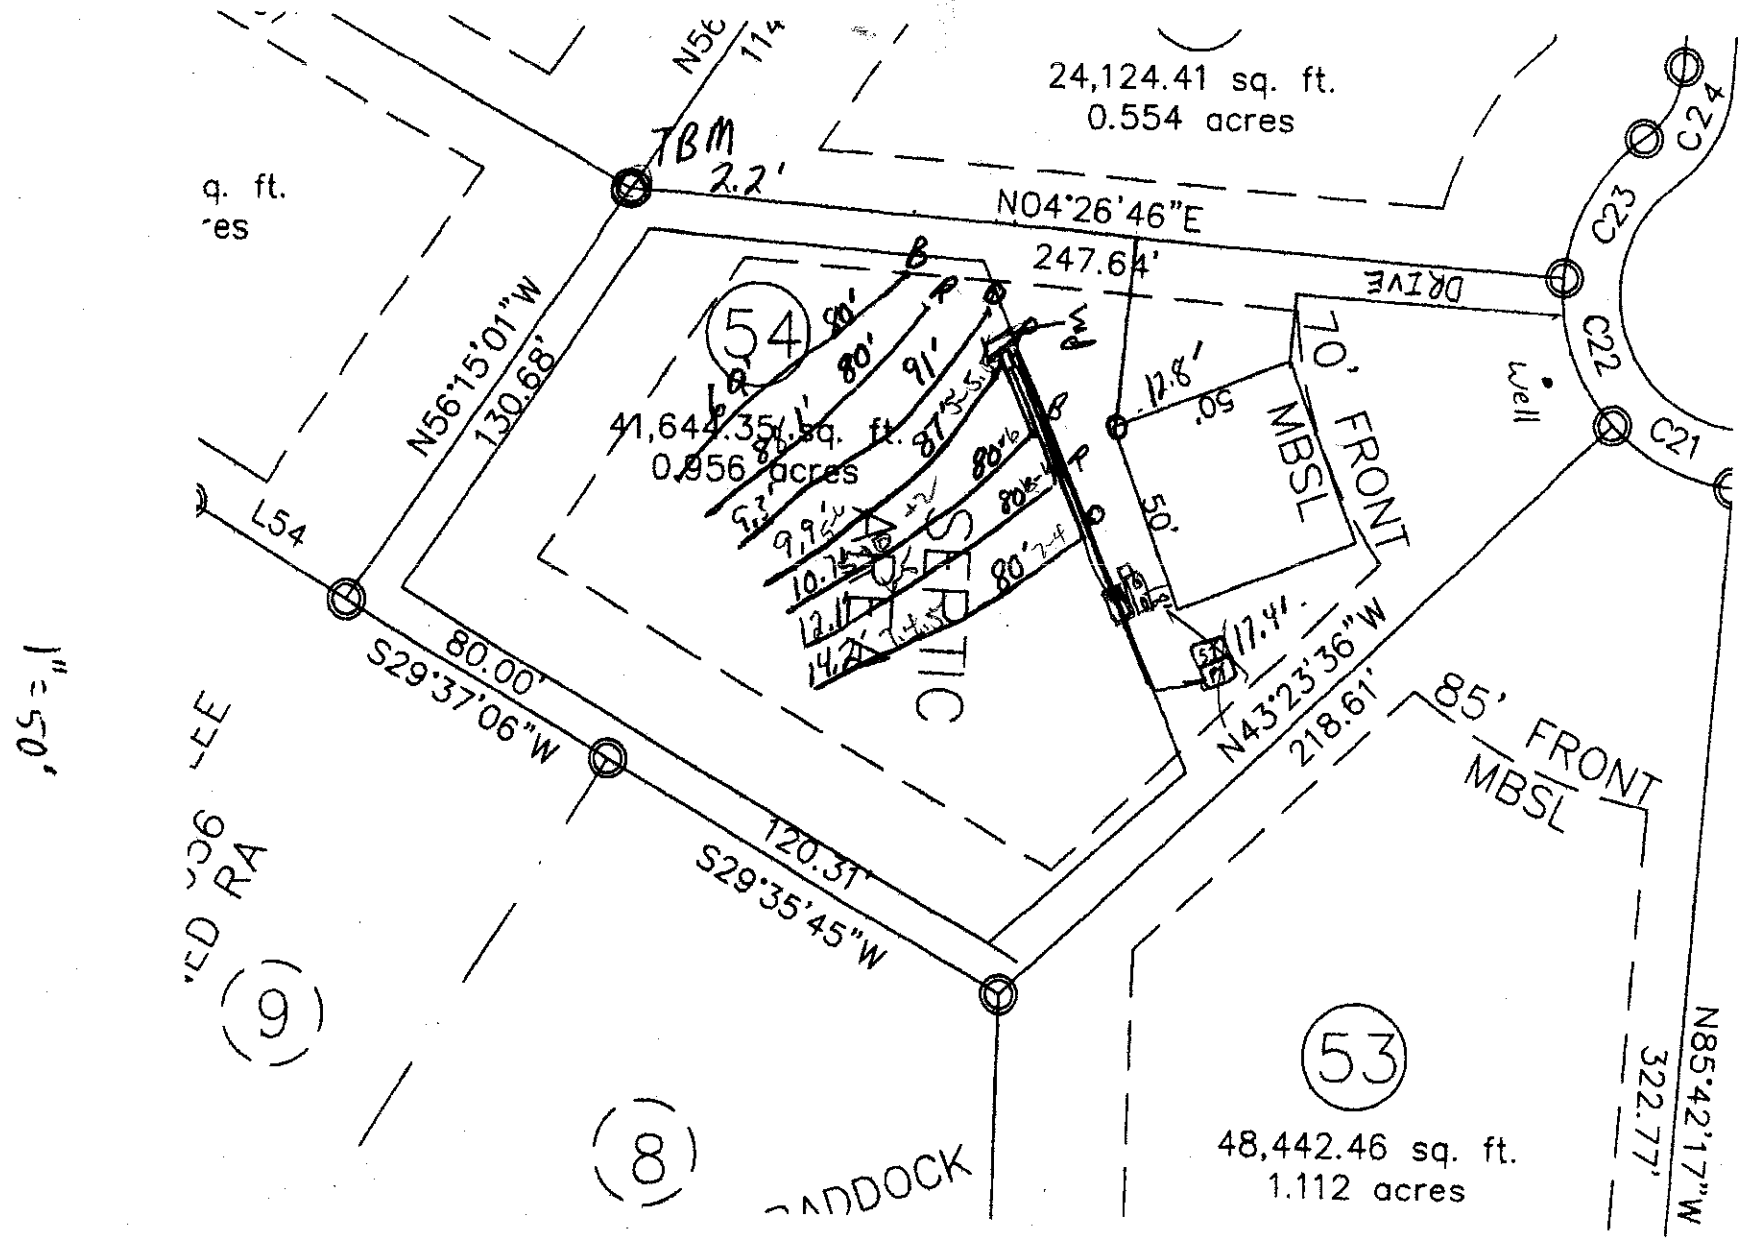
Permit can be suspended or revoked if any false information is supplied toward securing the permit/any unauthorized changes are made to the site/any unauthorized changes are made in the installation of the system. Improvement Permit with plat valid without expiration [ ] Improvement Permit with site plan valid for sixty months [X] Authorization to Construct is valid for a period equal to that of Improvement Permit – not to exceed sixty months.

Signed: Melissa Neal date 5-19-06 Installed by: Corinthian Builders

Improvement Permit by: [signature] date 5-18-06 Operation Permit by: Judy Malville date 11-1-06

Authorization to Construct by: [signature] date 5-18-06 Existing System Inspection by: _____ date _____

HEALTH DEPT. COPY: WHITE OWNER COPY (FINAL): YELLOW OWNER COPY (INITIAL): PINK


TBM
2.2'
N56°15'01"W
130.68'
N04°26'46"E
247.64'
24,124.41 sq. ft.
0.554 acres
41,644.35 sq. ft.
0.956 acres
54
L54
80.00'
S29°37'06"W
120.31'
S29°35'45"W
N43°23'36"W
218.61'
70' FRONT
MBSL
85' FRONT
MBSL
DRIVE
well
C21
C22
C23
C24
53
48,442.46 sq. ft.
1.112 acres
N85°42'17"W
322.77'
(9)
(8)
1" = 50'