IREDELL COUNTY HEALTH DEPARTMENT

STATESVILLE 704-878-5305 MOORESVILLE 704-664-5281

550.00 Paid

IMPROVEMENT PERMIT / AUTHORIZATION TO CONSTRUCT / OPERATION PERMIT / EXISTING SYSTEM INSPECTION

PERMIT# 135334 PIN# 4740 51 3845 PWS DATE 9/14/06

OWNER OR APPLICANT ~~PO Box 990 Denver, NC 28037~~ CORINTHIAN Phone: Business 704-400-1258 Home

ADDRESS PO Box 3421 Mooresville, NC. 28117

LOCATION FH LAN TL Carlyle Rd. TR Farmdale TR Loran to end. on L 1st dwlg sec

SUBDIVISION Carlyle Forms BLOCK / SECTION 3 LOT 51 LOT AREA 1.42 SITE CLASS PS DESIGN FLOW 360 L.T.A.R. .3

Septic Tank: 1000 Gallons; STB 785 Date 9-28-06 9-25-06

Pump Tank: 1000 Gallons; PT 32 Date 10-1-06

Pump Make: Myers Model ME50S-1 Serial No.

Nitrification Field: No Fields 1 Square Feet 600 Linear Feet 200

No Lines 3 @ 70' Trench Width 3' Max Trench Bottom Depth 3' Gravel Depth No

☒ New System ☐ Repair ☐ Expansion System Type: I II III IV V VI

System Description: LP - 16" PPBPS

Repair System Description: SAME TYPE

Maintenance Agreement Required: ☒ Yes ☐ No

☒ House/Mod. Home No. Bedrooms 3

☐ Mobile Home No. Persons

☐ Business No. Employees

☐ Other

Water Supply: ☒ Individual ☐ Public ☐ Community


☐ Gravity ☒ Pressure ☐ Slab ☒ Crawl Space ☐ Basement w/plumbing ☐ Basement wo/plumbing

Comments/Conditions:

1"=60'

GULLY

INITIAL SITE SKETCH

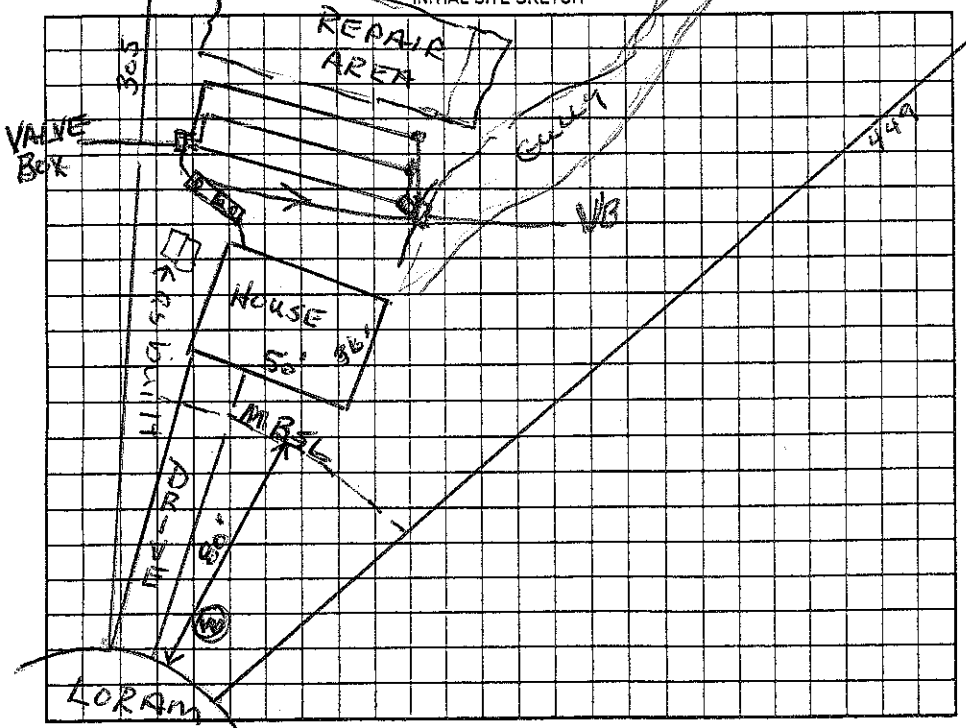

Comments/Conditions:

ST w/ marker
Blue poly lok filter
Lines checked 12-12-06 JM

AS BUILT SKETCH

3 @ 70' installed as per initial site sketch

Tanks set as noted

Permit can be suspended or revoked if any false information is supplied toward securing the permit/any unauthorized changes are made to the site/any unauthorized changes are made in the installation of the system. Improvement Permit with plat valid without expiration ☐ Improvement Permit with site plan valid for sixty months ☐ Authorization to Construct is valid for a period equal to that of Improvement Permit – not to exceed sixty months.

Signed: X Melissa Mea date 9-18-06

Improvement Permit by: Wesley Sparks RS. date 9/14/06

Authorization to Construct by: Wesley Sparks RS. date 9/14/06

Installed by: Corinthian Builders

Operation Permit by: Judy Melville date 2-12-07

Existing System Inspection by: date

HEALTH DEPT. COPY: WHITE OWNER COPY (FINAL): YELLOW OWNER COPY (INITIAL): PINK