IREDELL COUNTY HEALTH DEPARTMENT

STATESVILLE 704-878-5305 MOORESVILLE 704-664-5281

IMPROVEMENT PERMIT / AUTHORIZATION TO CONSTRUCT / OPERATION PERMIT / EXISTING SYSTEM INSPECTION

PERMIT# 072485 PIN# 4740 51 5328 DATE 4/13/98

OWNER OR CONTRACTOR Sunwood Builders PHONE: Business 872-0922 Home

ADDRESS PO Box 5877 Statesville, NC. 28687

LOCATION Flower House Loop Turn on Carlyle Rd. to 9th lot on (R) after Mocks Loop - 158 Carlyle Rd.

SUBDIVISION Carlyle Farms BLOCK / SECTION 2 LOT 18 LOT AREA ~.8 AC SITE CLASS. 25 DESIGN FLOW 360 L.T.A.R. .3

Septic Tank: 1080 Gallons; STB 1012 Date 3/25/98

Pump Tank: Gallons; PT Date

Pump Make: Model Serial No.

Nitrification Field: No Fields 1 Square Feet 1200 Linear Feet 400

No Lines 4 Trench Width 36" Max Trench Bottom Depth 36" Gravel Depth 12"

[X] New System [ ] Repair System Type: I, (II), III, IV, V, VI

System Description: New Conventional

Repair System Description: Same

Maintenance Agreement Required: [ ] Yes [X] No

[ ] House/Mod. Home No. Bedrooms 3

[X] Mobile Home No. Bathrooms 2

[ ] Business No. Employees

[ ] Other


[ ] Slab [X] Crawl Space [ ] Basement w/plumbing [ ] Basement wo/plumbing

Water Supply: [X] Individual [ ] Public [ ] Community

Comments:/Conditions:

Comments:/Conditions:

INITIAL SITE SKETCH

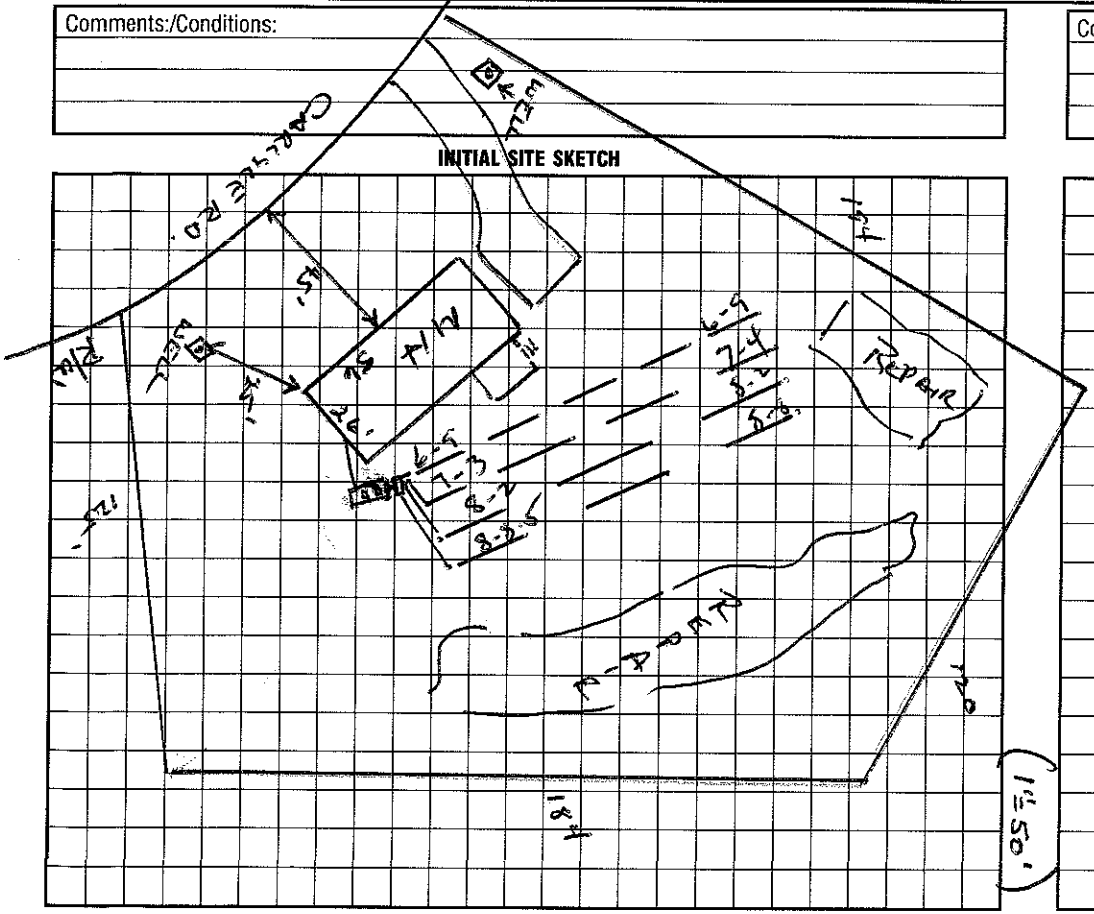

AS BUILT SKETCH

I understand that this permit can be suspended or revoked if any false information is supplied toward securing the permit/any unauthorized changes are made to the site/any unauthorized changes are made in the installation of the system. Improvement Permit with plat valid without expiration. Improvement Permit with site plan valid for sixty months. Authorization to Construct is valid for a period equal to that of Improvement Permit – not to exceed sixty months.

Signed: [signature] date

Improvement Permit by: Wesley Sparks R.S. date 4/13/98

Authorization to Construct by: Wesley Sparks R.S. date 4/13/98

Installed by: Tommy Frye

Operation Permit by: Wesley Sparks RS date 6/9/98

Existing System Inspection by: Wesley Sparks RS. date 6/9/98

HEALTH DEPT. COPY: WHITE INSPECTION COPY (FINAL): GREEN OWNER COPY (FINAL): YELLOW INSPECTION COPY (INITIAL): PINK OWNER COPY (INITIAL): GOLD