IREDELL COUNTY HEALTH DEPARTMENT

STATESVILLE 704-878-5305 MOORESVILLE 704-664-5281

IMPROVEMENT PERMIT / CERTIFICATE OF COMPLETION / OPERATION PERMIT / EXISTING SYSTEM INSPECTION

PROPERTY DESCRIPTION NO. 16799 DATE 8/18/93 TAX MAP NO. 4F 3A 8

OWNER OR CONTRACTOR CECIL HUTCHINS PHONE: Business ~~PVT~~ 474-0-51-5328 Home N/A

ADDRESS 114 MARLO LOOP TROUTMAN, NC

LOCATION CARLYLE RD, 1.15 N, TL ON FLOWER HOUSE TL CARLYLE TL 1ST MARLO BROUND CURVE, 3RD ON (L)

SUBDIVISION CARLYLE FARM BLOCK / SECTION ~~NA~~ 2 LOT 8 LOT AREA ~ 100' X 200 SITE CLASS. L.T.A.R.

Water Supply: ☐ Individual ☑ Community ☐ Public

Septic Tank: EXISTING Gallons; STB Date

Pump Tank: Gallons; PT Date

Nitrification Field: No Fields 1 Square Feet 720 Linear Feet 240

No Lines 3 Trench Width 36" Trench Depth 36" Gravel Depth

☐ New System ☐ Repair System Type: I, II, IV, V, VI

System Description:

Repair System Description:

Maintenance Agreement Required: ☐ Yes ☐ No

☑ House/Mod. Home ☐ Mobile Home ☐ Business ☐ Other

No. Bedrooms 3 No. Bathrooms 2 No. Employees

Garbage Disposal: ☐ Yes ☑ No

Auto. Dishwasher: ☑ Yes ☐ No

Auto. Washing Machine: ☑ Yes ☐ No


Other

☐ Slab ☑ Crawl Space ☐ Basement w/plumbing ☐ Basement wo/plumbing

Comments EXISTING SYSTEM

INITIAL SITE SKETCH

AS BUILT SKETCH

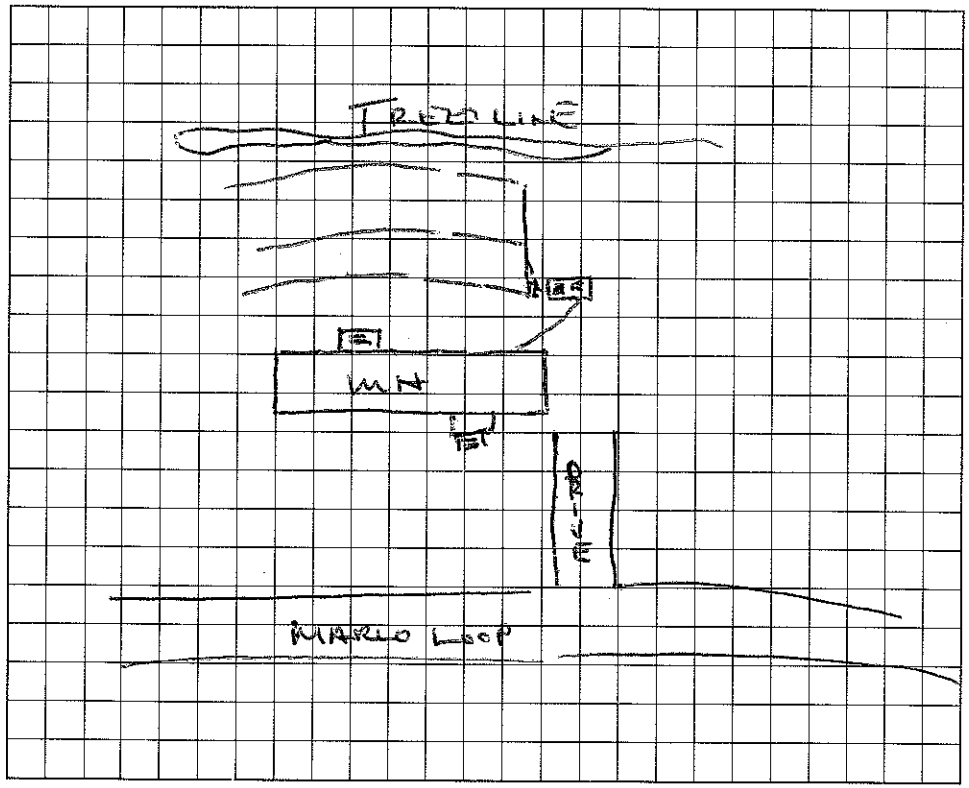

I understand that this permit can be suspended or revoked if any false information is supplied toward securing the permit/any unauthorized changes are made to the site/any unauthorized changes are made in the installation of the system. Improvement Permit is valid for 60 months from date of issuance.

Signed:

Improvement Permit by: date

Existing System Inspection by: Wesley Sparks R.S. date 8/18/93

Installed by:

Certificate of Completion by: date

Operation Permit by: date

HEALTH DEPT. COPY: WHITE INSPECTION COPY (FINAL): GREEN OWNER COPY (FINAL): YELLOW INSPECTION COPY (INITIAL): PINK OWNER COPY (INITIAL): GOLD