IREDELL COUNTY HEALTH DEPARTMENT

STATESVILLE 704-878-5305 MOORESVILLE 704-664-5281

IMPROVEMENT PERMIT / AUTHORIZATION TO CONSTRUCT / OPERATION PERMIT / EXISTING SYSTEM INSPECTION

11:00

PERMIT# 135349 PIN# 4740 51 5504

OWNER OR APPLICANT Corinthian Bldrs. DATE 9/19/06

ADDRESS Po Box 3421 Mooresville, NC 28117 PHONE: Business 704-400-1258 Home


SUBDIVISION Curlyle Farm BLOCK / SECTION LOT 53 LOT AREA ~1.11 Ac SITE CLASS PS DESIGN FLOW 360 L.T.A.R. .3

Septic Tank: 1000 Gallons: STB 786 Date 9-1-06

Pump Tank: 1000 Gallons: PT 32 Date 8-11-06

Pump Make: MYERS Model ME 50SIL Serial No 2535250287

Nitrification Field: No Fields 1 Square Feet 900 Linear Feet 300

No Lines 6@80, 8@80 Trench Width 3' Max Trench Bottom Depth 3' Gravel Depth No

[X] New System [ ] Repair [ ] Expansion System Type: I II (III) IV V VI

System Description: PM - 25% Reduced

Repair System Description: LP - 16" PPBPS

Maintenance Agreement Required: [ ] Yes [X] No

[X] House/Mod. Home [ ] Mobile Home [ ] Business [ ] Other

No. Bedrooms 3 No. Persons 3 No. Employees


Water Supply: [X] Individual [ ] Public [ ] Community

[ ] Gravity [X] Pressure [ ] Slab [X] Crawl Space [ ] Basement w/plumbing [ ] Basement wo/plumbing


Comments:/Conditions:

Comments:/Conditions: Drainfield
5TW/marker
Blue polylok filter

INITIAL SITE SKETCH (1"=60')

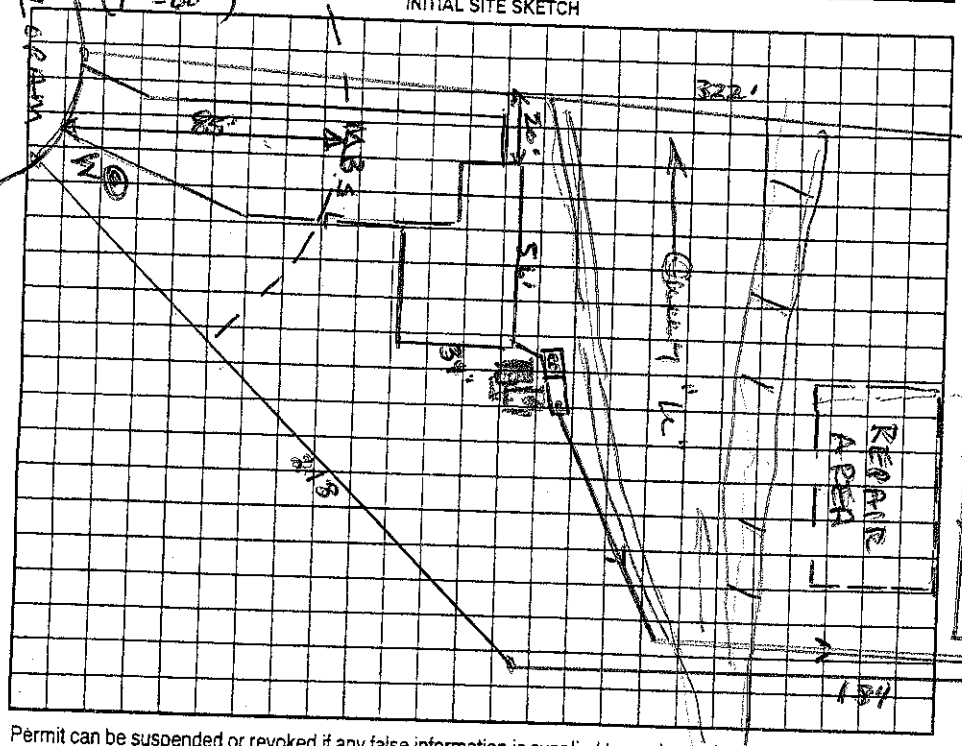

AS BUILT SKETCH

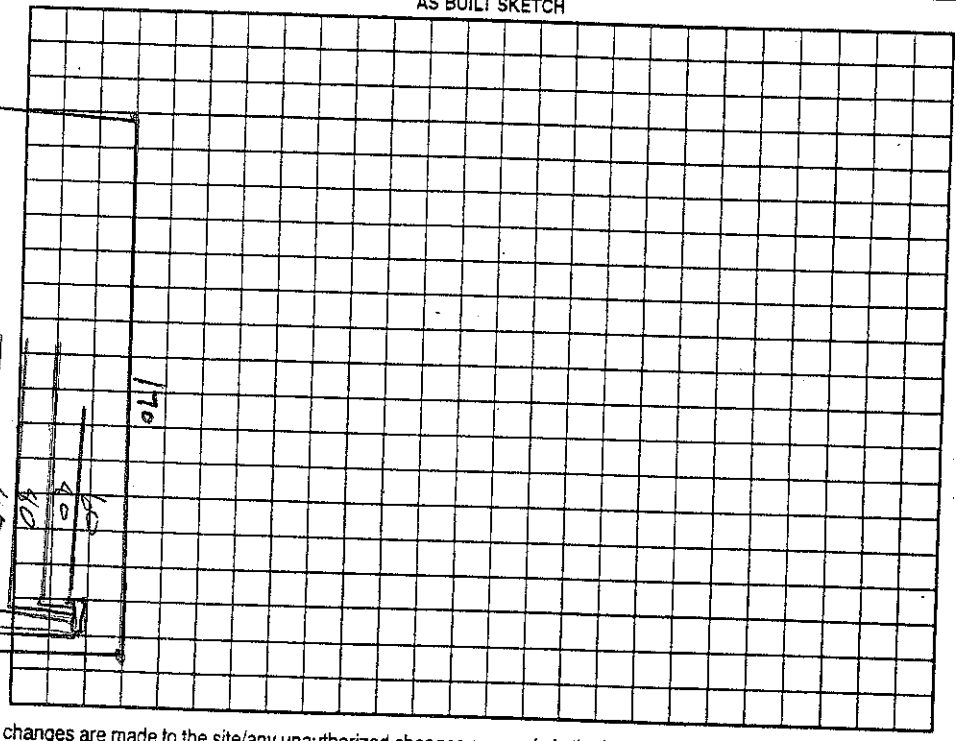

Permit can be suspended or revoked if any false information is supplied toward securing the permit/any unauthorized changes are made to the site/any unauthorized changes are made in the installation of the system. Improvement Permit with plat valid without expiration [ ] Improvement Permit with site plan valid for sixty months [X]

Authorization to Construct is valid for a period equal to that of Improvement Permit – not to exceed sixty months.

Signed: Melissa Neal date 9/20/06

Improvement Permit by: Wesley Sparks R.S. date 9/20/06

Authorization to Construct by: Wesley Sparks RS date 9/20/06

Installed by: Corinthian Developers

Operation Permit by: Wesley Sparks RS date 1/9/07

Existing System Inspection by: date

HEALTH DEPT. COPY: WHITE OWNER COPY (FINAL): YELLOW OWNER COPY (INITIAL): PINK