IREDELL COUNTY HEALTH DEPARTMENT

STATESVILLE 704-878-5305 MOORESVILLE 704-664-5281

IMPROVEMENT PERMIT / AUTHORIZATION TO CONSTRUCT / OPERATION PERMIT / EXISTING SYSTEM INSPECTION

PERMIT# 135348 PIN# 4740 51 5711 DATE

OWNER OR APPLICANT Corinthian Blders PHONE: Business Home

ADDRESS PO Box 3421 Mooresville NC 28117

LOCATION 115 N, TL Flowerhouse, TL Carlyle, TR Farmdale, TR Holmfield, TR Largon, at end

SUBDIVISION Carlyle Farms BLOCK / SECTION LOT 52 LOT AREA 1.481 Ac SITE CLASS. PS DESIGN FLOW 360 L.T.A.R. 0.3

Septic Tank: 1000 Gallons; STB 55 Date 9-18-06
Pump Tank: 1000 Gallons; PT 32 Date 9-28-06
Pump Make: Myers Model ME50S-11 Serial No.
Nitrification Field: No Fields 1 Square Feet 900 Linear Feet 300'
No Lines 5@60' Trench Width 36" Max Trench Bottom Depth 36"

☒ New System ☐ Repair ☐ Expansion System Type: I II III IV V VI
System Description: 25% Reduction
Repair System Description: Same
Maintenance Agreement Required: ☐ Yes ☒ No

☒ House/Mod. Home No. Bedrooms 3
☐ Mobile Home No. Persons
☐ Business No. Employees
☐ Other

Water Supply: ☒ Individual ☐ Public ☐ Community


Gravel Depth — ☐ Gravity ☒ Pressure ☐ Slab ☒ Crawl Space ☐ Basement w/plumbing ☐ Basement wo/plumbing

Comments:/Conditions:


1" = 60'

Comments:/Conditions: blue polylok filter in ST

INITIAL SITE SKETCH

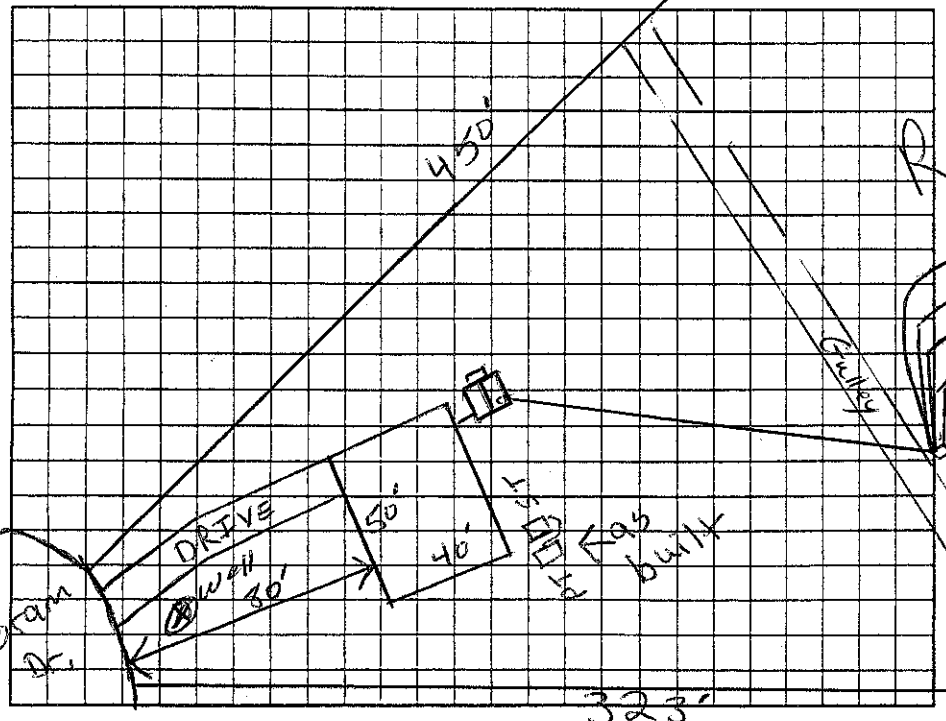

AS BUILT SKETCH

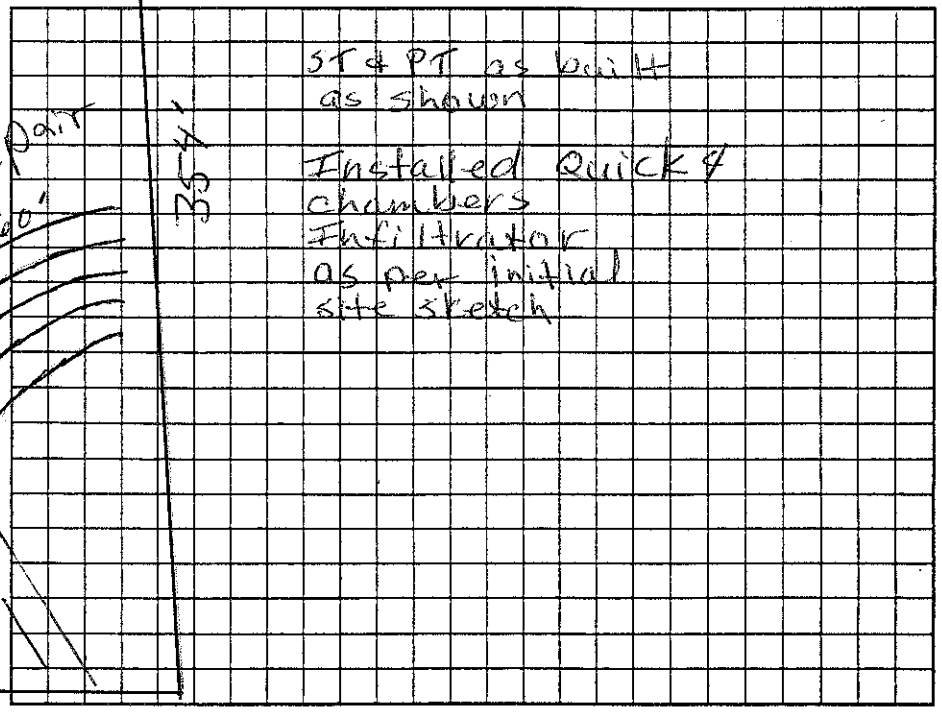

Permit can be suspended or revoked if any false information is supplied toward securing the permit/any unauthorized changes are made to the site/any unauthorized changes are made in the installation of the system. Improvement Permit with plat valid without expiration. ☐ Improvement Permit with site plan valid for sixty months ☐ Authorization to Construct is valid for a period equal to that of Improvement Permit – not to exceed sixty months.

Signed: Melissa Neal date 9/13/06 Installed by: Corinthian Builders

Improvement Permit by: RS date 9/12/06 Operation Permit by: Judy Melvill date 2-12-07

Authorization to Construct by: RS date 9/14/06 Existing System Inspection by: date

HEALTH DEPT. COPY: WHITE OWNER COPY (FINAL): YELLOW OWNER COPY (INITIAL): PINK