IREDELL COUNTY HEALTH DEPARTMENT

STATESVILLE 704-878-5305 MOORESVILLE 704-664-5281

IMPROVEMENT PERMIT / AUTHORIZATION TO CONSTRUCT / OPERATION PERMIT / EXISTING SYSTEM INSPECTION

PERMIT# 072484 PIN# 4740 51 6026 DATE 4/13/98

OWNER OR CONTRACTOR Sunwood Builders PHONE: Business 872-0922 Home

ADDRESS PO Box 5877 Statesville, NC 28687

LOCATION Fergus House Loop Turn on Carlyle Rd on (L) Leopard Mark Loop

SUBDIVISION Carlyle Farms BLOCK / SECTION 2 LOT 62 LOT AREA .53 SITE CLASS RS DESIGN FLOW 360 L.T.A.R. .3

Septic Tank: 1000 Gallons; STB 1012 Date 4/16/98
Pump Tank: Gallons; PT Date
Pump Make: Model Serial No.
Nitrification Field: No Fields 1 Square Feet 900± Linear Feet 300±
No Lines 5 Trench Width 36" Max Trench Bottom Depth 36" Gravel Depth SAND

[X] New System ☐ Repair System Type: I, II, (III) IV, V, VI
System Description: GRAY - CH PLASTIC
Repair System Description: SAME
Maintenance Agreement Required: ☐ Yes [X] No


☐ House/Mod. Home No. Bedrooms 3
[X] Mobile Home No. Bathrooms 2
☐ Business No. Employees
☐ Other
☐ Slab [X] Crawl Space ☐ Basement w/plumbing ☐ Basement wo/plumbing

Water Supply: [X] Individual ☐ Public ☐ Community


Comments:/Conditions: ± 25% Reduction for CH Plastic use ±

Comments:/Conditions: Installed as shown.

INITIAL SITE SKETCH

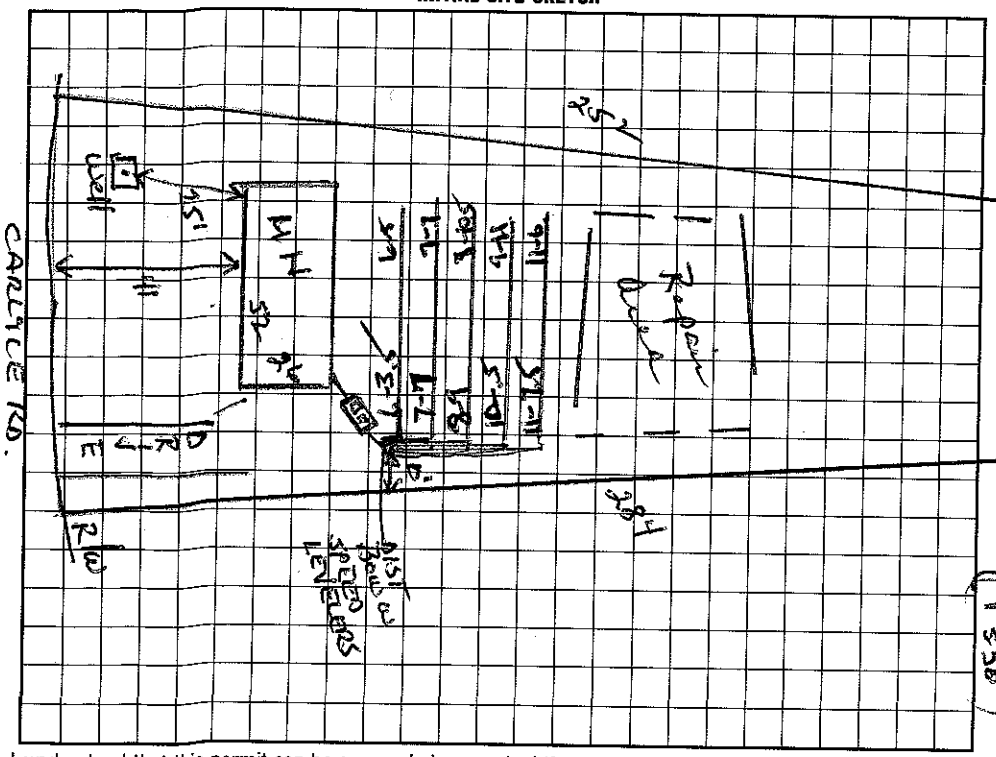

AS BUILT SKETCH

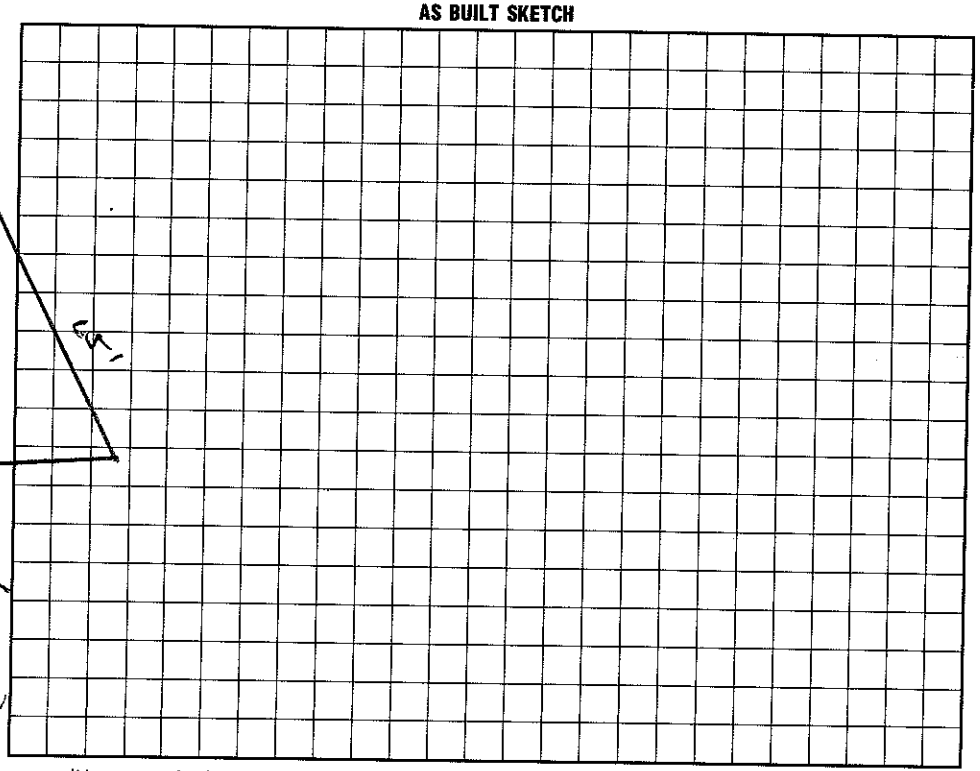

I understand that this permit can be suspended or revoked if any false information is supplied toward securing the permit/any unauthorized changes are made to the site/any unauthorized changes are made in the installation of the system. Improvement Permit with plat valid without expiration. Improvement Permit with site plan valid for sixty months. Authorization to Construct is valid for a period equal to that of Improvement Permit – not to exceed sixty months.

Signed: ± Perry W Jenkins date

Improvement Permit by: Wesley Sparks R.S. date 4/13/98

Authorization to Construct by: Wesley Sparks R.S. date 4/13/98

Installed by: Tommy Frye

Operation Permit by: Wesley Sparks R.S. date 6/22/98

Existing System Inspection by: Wesley Sparks R.S. date 6/22/98

HEALTH DEPT. COPY: WHITE INSPECTION COPY (FINAL): GREEN OWNER COPY (FINAL): YELLOW INSPECTION COPY (INITIAL): PINK OWNER COPY (INITIAL): GOLD