4.00

IREDELL COUNTY HEALTH DEPARTMENT

'ILLE 704-878-5305 MOORESVILLE 704-664-5281

IMPROVEMENT PERMIT / AUTHORIZATION TO CONSTRUCT / OPERATION PERMIT / EXISTING SYSTEM INSPECTION

PERMIT# 116.364 ZO PIN# 4740516156 DATE 12/5/03

OWNER OR CONTRACTOR Fleetwood Homes PHONE: Business 528-7120 Home

ADDRESS 1040 Charlotte Hwy Troutman, NC 28166

LOCATION Hwy 21/115 North TO Flowerhouse Lp IL Carlyle ~ 1/2 mile on left

SUBDIVISION Carlyle Farms BLOCK / SECTION 2 LOT 1 LOT AREA .51 Acre SITE CLASS. RS DESIGN FLOW 360gpd L.T.A.R. .3

Septic Tank: 1000 Gallons; STB 1012 Date 11-5-03

Pump Tank: Gallons; PT Date

Pump Make: Model Serial No.

Nitrification Field: No Fields 1 Square Feet 900 Linear Feet 300'

No Lines 30 75' Trench Width 36" Max Trench Bottom Depth 36 Gravel Depth N/A

☒ New System ☐ Repair System Type: I, II, III, IV, V, VI

System Description: Gravity -- 25% Reduction

Repair System Description: Innovative

Maintenance Agreement Required: ☐ Yes ☒ No

☐ House/Mod. Home ☒ Mobile Home ☐ Business ☐ Other

No. Bedrooms 3 No. Bathrooms 2 No. Employees


☐ Slab ☒ Crawl Space ☐ Basement w/plumbing ☐ Basement wo/plumbing

Water Supply: ☒ Individual ☐ Public ☐ Community


Comments:/Conditions: Keep Septic System at least 10' From PL & 50-100' From any well

Comments:/Conditions:

INITIAL SITE SKETCH Scale 1:40

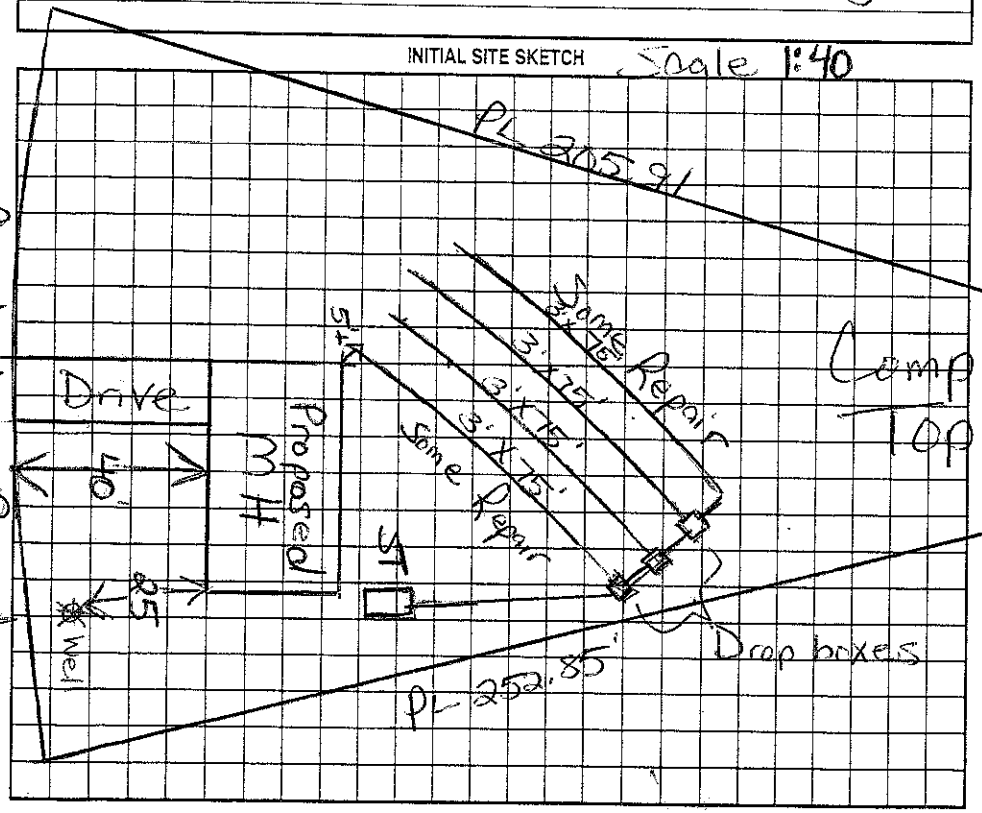

AS BUILT SKETCH

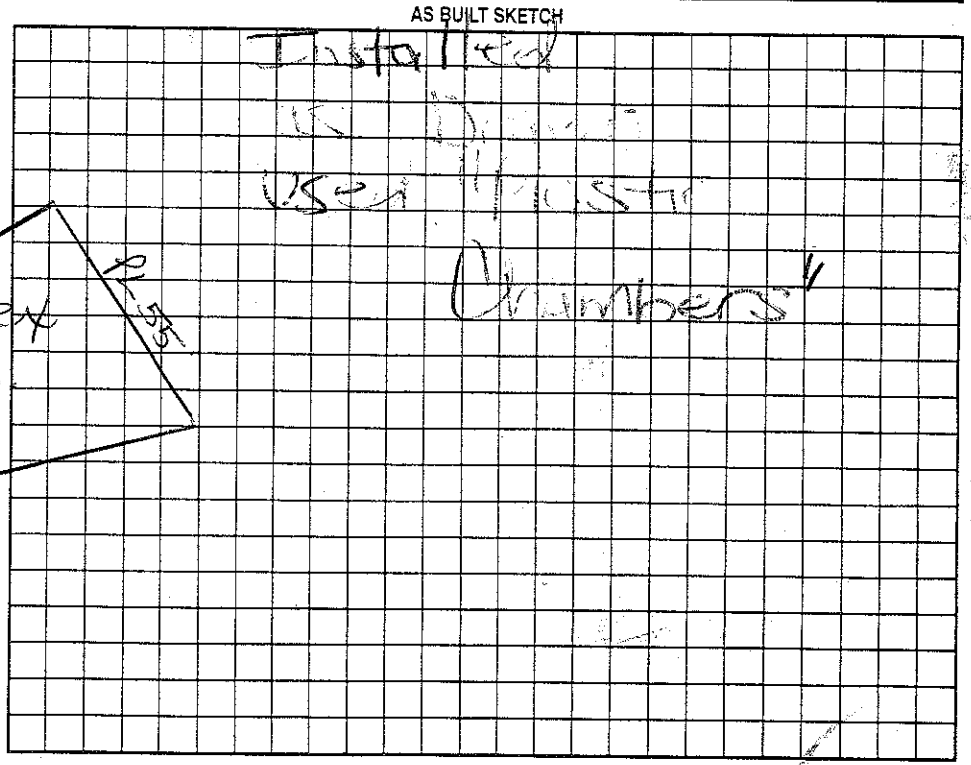

Permit can be suspended or revoked if any false information is supplied toward securing the permit/any unauthorized changes are made to the site/any unauthorized changes are made in the installation of the system. Improvement Permit with plat valid without expiration. Improvement Permit with site plan valid for sixty months. Authorization to Construct is valid for a period equal to that of Improvement Permit – not to exceed sixty months.

Signed: date 12-9-03

Improvement Permit by: Maria H. Dotson RS date 12/5/03

Authorization to Construct by: Maria H. Dotson RS date 12/5/03

Installed by: Craig Edison

Operation Permit by: Maria H. Dotson date 3/2/04

Existing System Inspection by: date

HEALTH DEPT. COPY: WHITE OWNER COPY (FINAL): YELLOW OWNER COPY (INITIAL): PINK