IREDELL COUNTY HEALTH DEPARTMENT

STATESVILLE 704-878-5305 MOORESVILLE 704-664-5281

IMPROVEMENT PERMIT / AUTHORIZATION TO CONSTRUCT / OPERATION PERMIT / EXISTING SYSTEM INSPECTION

PERMIT# Existing Building PIN# 4740518574.000 DATE 12/21/07

OWNER OR APPLICANT Scott Bailey (owner Rehabilitation Financing) PHONE: Business _____ Home _____

ADDRESS 1500 South Blvd ste 201b Charlotte NC 28203

LOCATION Hwy 21 N/115 N TL Flowerhouse Loop TR Carlyle Rd. on Right 142 Carlyle

SUBDIVISION N/A BLOCK / SECTION _____ LOT _____ LOT AREA .45 SITE CLASS. PS DESIGN FLOW 360 L.T.A.R. .25

Septic Tank: 1000 Gallons: STB 1007 Date 11-20-07
Pump Tank: _____ Gallons: PT _____ Date _____
Pump Make: _____ Model _____ Serial No. _____
Nitrification Field: No Fields 1 Square Feet 1080' Linear Feet 360'
No Lines 5@72' Trench Width 36" Max Trench Bottom Depth 36" Gravel Depth N/A

☑ New System ☐ Repair ☐ Expansion System Type: I (II) III IV V VI
System Description: Gravity 25% Reduction
Repair System Description: Gravity or Pump Panel
Maintenance Agreement Required: ☐ Yes ☑ No


☑ House/Mod. Home No. Bedrooms 3
☐ Mobile Home No. Persons _____
☐ Business No. Employees _____
☐ Other _____

Water Supply: ☑ Individual ☐ Public ☐ Community

☑ Gravity ☐ Pressure ☐ Slab ☑ Crawl Space ☐ Basement w/plumbing ☐ Basement wo/plumbing

Comments:/Conditions: 100'
* Abandon Existing septic tank + drainline (Remove or Fill)
Evenly Distribute using D'box + flow levelers if possible.

INITIAL SITE SKETCH

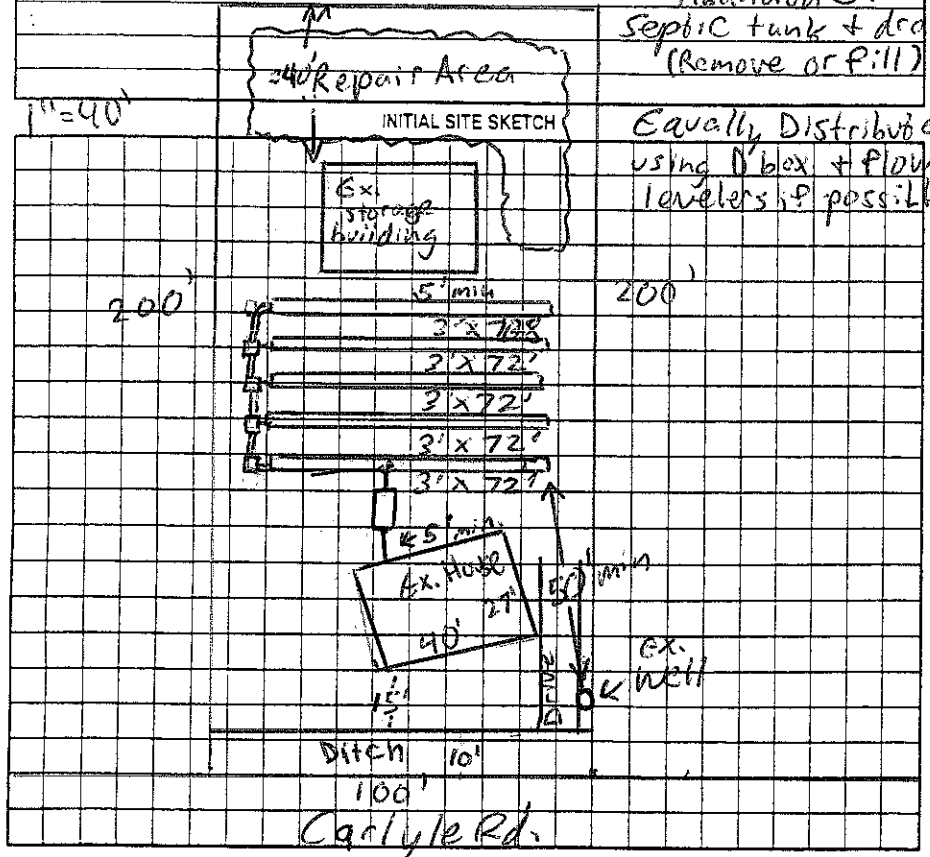

Comments:/Conditions: Maintain 50' min. from all wells.
2/15/08 Checked ST & 4 of 5 lines
* Install New Septic tank + Drainlines
2/15/08 Filter installed
2/19/08 Checked 5th line

AS BUILT SKETCH

* Storage building must not be used as a garage
= More can be no driving over septic System.

Used Quick 4 for Drainfield
5 lines ~ 75' ea
1 line @ 68'

Permit can be suspended or revoked if any false information is supplied toward securing the permit/any unauthorized changes are made to the site/any unauthorized changes are made in the installation of the system. Improvement Permit with plat valid without expiration ☐ Improvement Permit with site plan valid for sixty months ☑ Authorization to Construct is valid for a period equal to that of Improvement ~~Permit~~ – not to exceed sixty months.

Signed: _____ date 1/3/08 Installed by: Union Grove Septic

Improvement Permit by: Anthony Coker Jr. date 12/21/07 Operation Permit by: Manuel Deleon RS date 2/19/08

Authorization to Construct by: Anthony Coker Jr. date 12/21/07 Existing System Inspection by: _____ date _____

HEALTH DEPT. COPY: WHITE OWNER COPY (FINAL): YELLOW OWNER COPY (INITIAL): PINK