(Formerly Lot 2)

IREDELL COUNTY HEALTH DEPARTMENT

STATESVILLE 704-878-5305 MOORESVILLE 704-664-5281

IMPROVEMENT PERMIT / AUTHORIZATION TO CONSTRUCT / OPERATION PERMIT / EXISTING SYSTEM INSPECTION

PERMIT# 086486 PIN# ~~4740328058 PT~~ 4740-52-0802 DATE 11/22/99

OWNER OR CONTRACTOR Spears Construction PHONE: Business 361-7518 Home

ADDRESS 607 Anderson Salisbury, NC 28144

LOCATION Perth Rd TR Clontz Hill TR into Forest Glen at intersection on right

SUBDIVISION Forest Glen BLOCK / SECTION LOT 13 LOT AREA .55 Acre SITE CLASS. PS DESIGN FLOW 360gpd L.T.A.R. .3

Septic Tank: 1000 Gallons; STB Date
Pump Tank: Gallons; PT Date
Pump Make: Model Serial No.
Nitrification Field: No Fields 1 Square Feet 900' Linear Feet 300'
No Lines 4 at 75' Trench Width 36" Max Trench Bottom Depth 36" Gravel Depth N/A

☒ New System ☐ Repair System Type: I, II, III, IV, V, VI
System Description: Gravity – 25% Reduction
Repair System Description: Gravity – Innovative
Maintenance Agreement Required: ☐ Yes ☒ No

☒ House/Mod. Home No. Bedrooms 3
☐ Mobile Home No. Bathrooms 2
☐ Business No. Employees
☐ Other


☒ Slab ☐ Crawl Space ☐ Basement w/plumbing ☐ Basement wo/plumbing

Water Supply: ☒ Individual ☐ Public ☐ Community

Comments:/Conditions: Keep Septic System 10' From PL, 5' from house & 50' (at least) from well

Comments:/Conditions:

INITIAL SITE SKETCH Scale 1:50'

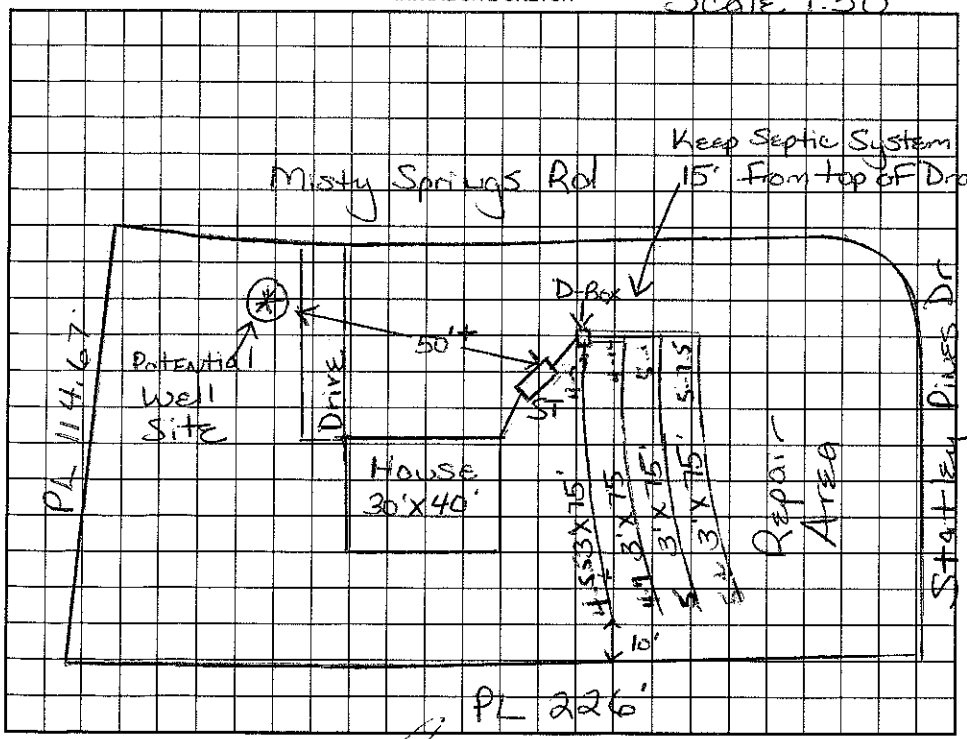

AS BUILT SKETCH

Permit can be suspended or revoked if any false information is supplied toward securing the permit/any unauthorized changes are made to the site/any unauthorized changes are made in the installation of the system. Improvement Permit with plat valid without expiration. Improvement Permit with site plan valid for sixty months. Authorization to Construct is valid for a period equal to that of Improvement Permit – not to exceed sixty months.

Signed: date 12-10-99 Installed by: Rowan Septic Tank

Improvement Permit by: Maria H. Dotson R.S. date 11/22/99 Operation Permit by: Wesley Sparks R.S. date 2/9/00

Authorization to Construct by: Maria H. Dotson R.S. date 11/22/99 Existing System Inspection by: date

HEALTH DEPT. COPY: WHITE OWNER COPY (FINAL): YELLOW OWNER COPY (INITIAL): PINK