330 - 4

IREDELL COUNTY HEALTH DEPARTMENT

STATESVILLE 704-878-5305 MOORESVILLE 704-664-5281

IMPROVEMENT PERMIT / AUTHORIZATION TO CONSTRUCT / OPERATION PERMIT / EXISTING SYSTEM INSPECTION

PERMIT# 086487 PIN# ~~4740328058 PT~~ 4740-52-0912 DATE 1-13-2000

OWNER OR CONTRACTOR Spears Construction PHONE: Business 636-7954 Home

ADDRESS 607 Anderson Ave Salisbury, NC 28144

LOCATION Hwy 115 N. TL Flowerhouse TR Clontz Hill TL Stately Pines at intersection w/ Misty Spgs.

SUBDIVISION Forest Glen BLOCK / SECTION LOT 14 LOT AREA .61 Acre SITE CLASS. PS DESIGN FLOW 360gpd L.T.A.R. .3

Septic Tank: 1000 Gallons; STB 825 Date 1-12-2000 ☒ New System ☐ Repair System Type: I, II, III, IV, V, VI

Pump Tank: Gallons; PT Date System Description: Gravity-Conventional

Pump Make: Model 1200 Serial No. 400 Repair System Description: Modified-25% Red.

Nitrification Field: No Fields 1 Square Feet ~~900~~ 900' Linear Feet ~~300~~ 300' Maintenance Agreement Required: ☐ Yes ☒ No

No Lines ~~4~~ 5 Trench Width 36" Max Trench Bottom Depth 36" Gravel Depth N/A

☒ House/Mod. Home No. Bedrooms 3 ☐ Mobile Home No. Bathrooms 2 ☐ Business No. Employees ☐ Other


☐ Slab ☒ Crawl Space ☐ Basement w/plumbing ☐ Basement wo/plumbing

Water Supply: ☒ Individual ☐ Public ☐ Community

Comments/Conditions: Keep Septic System at least 10' From PL, 5' From House & 50' to 100' From well. Stub plumbing out high enough for gravity flow.

Comments/Conditions: Installed Filter @ 4-100'

INITIAL SITE SKETCH Scale 1:50

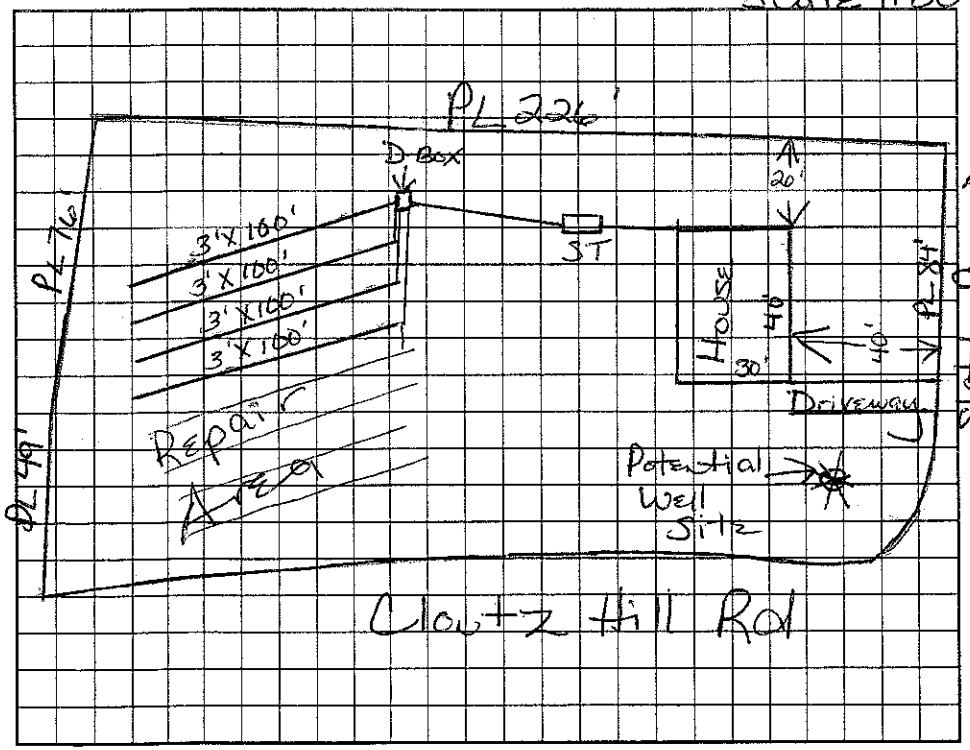

AS BUILT SKETCH

System installed in Repair Area - Now Repair Area will be pumped. 3/22/2000

Permit can be suspended or revoked if any false information is supplied toward securing the permit/any unauthorized changes are made to the site/any unauthorized changes are made in the installation of the system. Improvement Permit with plat valid without expiration. Improvement Permit with site plan valid for sixty months. Authorization to Construct is valid for a period equal to that of Improvement Permit – not to exceed sixty months.

Signed: date 2-3-00 Installed by: Rowan Septic

Improvement Permit by: Maria H. Dotson date 1/18/2000 Operation Permit by: Maria H. Dotson RS date 3/22/2000

Authorization to Construct by: Maria H. Dotson date 1/18/2000 Existing System Inspection by: date

HEALTH DEPT. COPY: WHITE OWNER COPY (FINAL): YELLOW OWNER COPY (INITIAL): PINK