4100

IREDELL COUNTY HEALTH DEPARTMENT

STATESVILLE 704-878-5305 MOORESVILLE 704-664-5281

IMPROVEMENT PERMIT / AUTHORIZATION TO CONSTRUCT / OPERATION PERMIT / EXISTING SYSTEM INSPECTION

PERMIT# 087192 PIN# ~~4740328058 Pt~~ 4740-52-1883 DATE 3/27/2000

OWNER OR CONTRACTOR Max Spears PHONE: Business 202-4964 Home 636-7954

ADDRESS 607 Anderson Ave Salisbury NC

LOCATION Hwy 115 TL Flowerhouse TL Waltz Hill TR Stately Pines TL, Misty Spgs

SUBDIVISION Forest Glen BLOCK / SECTION 2 LOT 15 LOT AREA ____ SITE CLASS. P DESIGN FLOW 360gpd L.T.A.R. ____

Septic Tank: 1000 Gallons; STB X25 Date 3-4-00
Pump Tank: 1000 Gallons; PT 302 Date 3-6-00
Pump Make: Zoeller Model N98 Serial No. ____
Nitrification Field: No Fields 1 Square Feet 900' Linear Feet 300'
No Lines 4@75' Trench Width 36" Max Trench Bottom Depth 36" Gravel Depth N/A

☒ New System ☐ Repair System Type: I, II, III, IV, V, VI
System Description: Pump (pm) 25% Reduction
Repair System Description: Pump-Innovative
Maintenance Agreement Required: ☐ Yes ☒ No


☒ House/Mod. Home No. Bedrooms 3
☐ Mobile Home No. Bathrooms 2
☐ Business No. Employees ____
☐ Other ____
☐ Slab ☐ Crawl Space ☐ Basement w/plumbing ☐ Basement wo/plumbing

Water Supply:
☒ Individual
☐ Public
☐ Community

Comments/Conditions: Keep Septic System 10' From PL, 5' From House & 50' From Well

Comments/Conditions: Okay if Septic Installer Can Install 3@100' lines on contour instead. Tanks, lines & pressure checked 5/4/2000 MB Filter & riser installed

INITIAL SITE SKETCH Scale 1:50

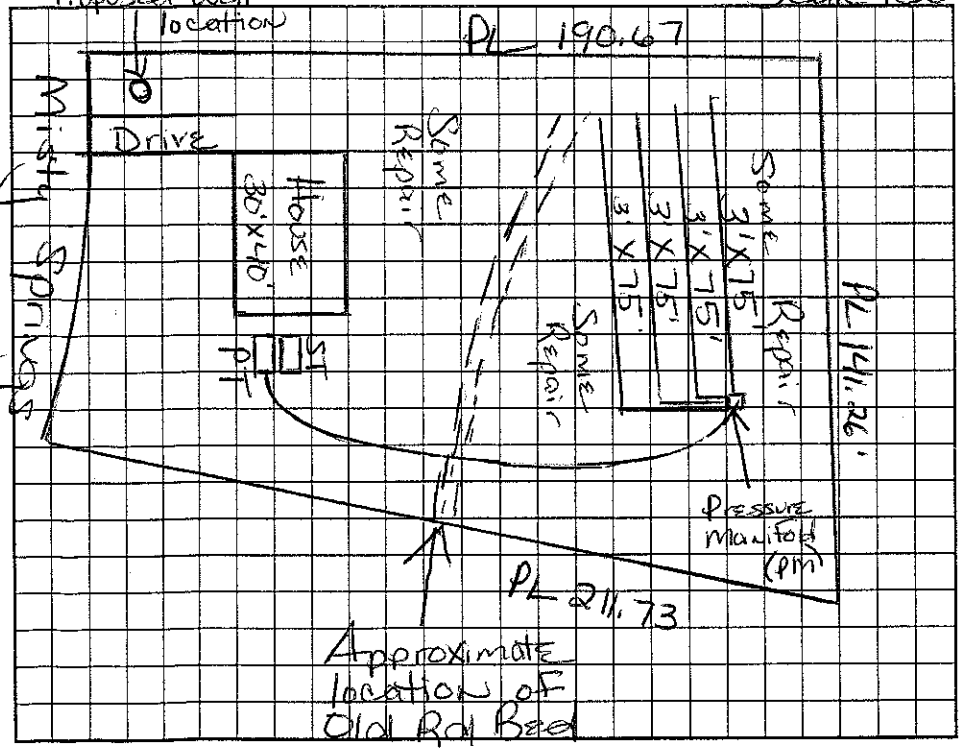

AS BUILT SKETCH

Installed as Drawn

Permit can be suspended or revoked if any false information is supplied toward securing the permit/any unauthorized changes are made to the site/any unauthorized changes are made in the installation of the system. Improvement Permit with plat valid without expiration. Improvement Permit with site plan valid for sixty months. Authorization to Construct is valid for a period equal to that of Improvement Permit – not to exceed sixty months.

Signed: X ____ date 3-29-00 Installed by: Rowan Septic Tank

Improvement Permit by: Maria H. Dotson date 3/28/2000 Operation Permit by: Wesley Sparks RS. date 5/25/00

Authorization to Construct by: Maria H. Dotson date 3/28/2000 Existing System Inspection by: ____ date ____

HEALTH DEPT. COPY: WHITE OWNER COPY (FINAL): YELLOW OWNER COPY (INITIAL): PINK