IREDELL COUNTY HEALTH DEPARTMENT

STATESVILLE 704-878-5305 MOORESVILLE 704-664-5281

IMPROVEMENT PERMIT / AUTHORIZATION TO CONSTRUCT / OPERATION PERMIT / EXISTING SYSTEM INSPECTION

PERMIT# 105281 PIN# 4740524774 Max Jr DATE 1-16-03

OWNER OR CONTRACTOR Max Spears / Gary Morrison PHONE: Business 262-4964 Home

ADDRESS ~~123~~ 607 Anderson Ave Salisbury NC 28144

LOCATION Hwy 115/21 TL Flowerhouse TL Clontz Hill TL Forest Glen TL Misty Springs on left

SUBDIVISION Forest Glen BLOCK / SECTION LOT 17 LOT AREA SITE CLASS. PS DESIGN FLOW 360gpd L.T.A.R. .39

Install New reloc existing ST

Septic Tank: 1000 Gallons; STB 825 Date 8-7-00

Pump Tank: Gallons; PT Date

Pump Make: Model Serial No.

Nitrification Field: No Fields 1 Square Feet 900' Linear Feet 300'

No Lines 3@100' Trench Width 36" Max Trench Bottom Depth 36" Gravel Depth N/A

Existing

☒ New System ST ☐ Repair System Type: I, II, III, IV, V, VI

System Description: Drainfield-existing Gravity-25% Reduction

Repair System Description: Pump-Modified

Maintenance Agreement Required: ☐ Yes ☒ No

☒ House/Mod. Home No. Bedrooms 3

☐ Mobile Home No. Bathrooms 2

☐ Business No. Employees

☐ Other

☐ Slab ☒ Crawl Space ☐ Basement w/plumbing ☐ Basement wo/plumbing


Water Supply: ☒ Individual ☐ Public ☐ Community

Comments/Conditions: Hook new ST to existing Dbox & drainfield

Comments/Conditions: House to be moved out of R/W. "Properly abandon" old ST & install New ST as indicated on drawing. Encroachment Agreement allows Drainfield to stay in R/W.

Scale = 1:60

INITIAL SITE SKETCH

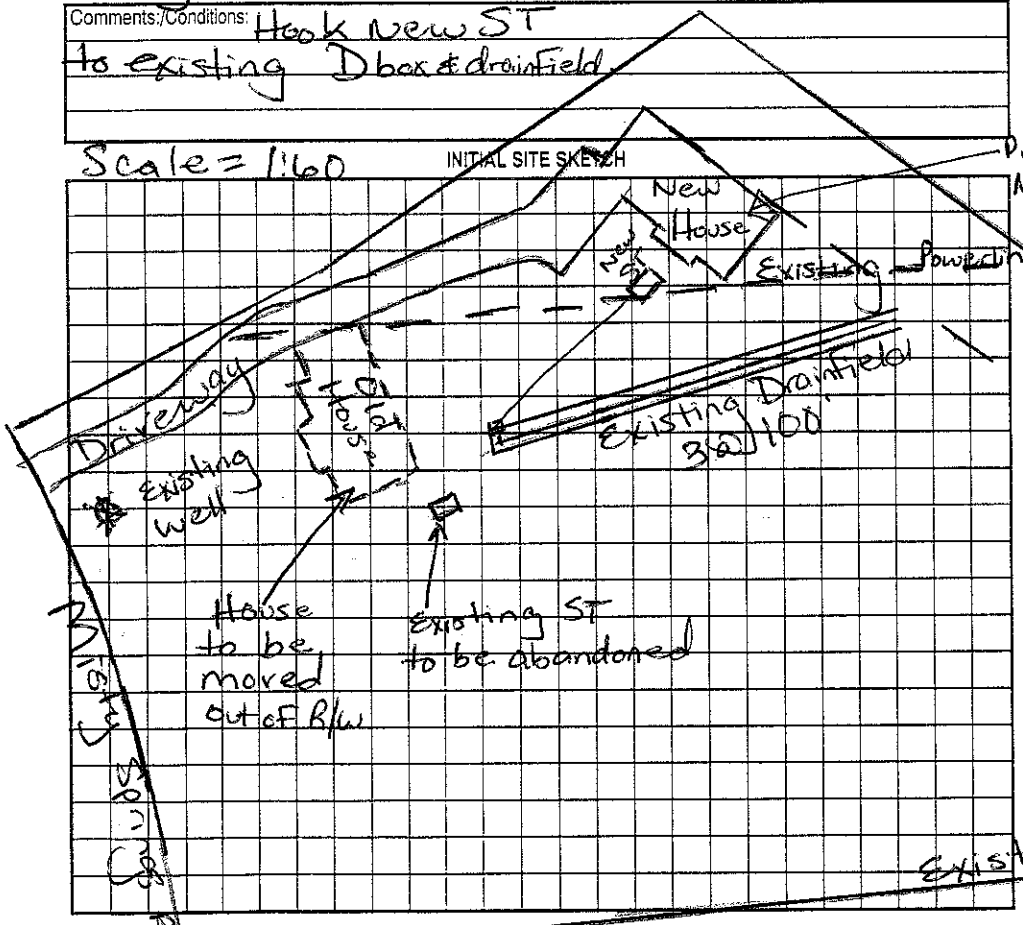

AS BUILT SKETCH

Moved Existing ST to new ST location Visually inspection of ST - It Appears to be okay Filter still intact. Installed new D-box.

No Speed levelers Used

425.93'

514.55

Permit can be suspended or revoked if any false information is supplied toward securing the permit/any unauthorized changes are made to the site/any unauthorized changes are made in the installation of the system. Improvement Permit with plat valid without expiration. Improvement Permit with site plan valid for sixty months. Authorization to Construct is valid for a period equal to that of Improvement Permit – not to exceed sixty months.

Signed: Stanley P. Sharpe date

Improvement Permit by: Maria H. Dolan RS date 1/16/03

Authorization to Construct by: Maria H. Dolan RS date 1/16/03

Installed by: Rowan Septic

Operation Permit by: Maria H. Dolan RS date 3/28/03

Existing System Inspection by: date

HEALTH DEPT. COPY: WHITE OWNER COPY (FINAL): YELLOW OWNER COPY (INITIAL): PINK