IREDELL COUNTY HEALTH DEPARTMENT

STATESVILLE 704-878-5305 MOORESVILLE 704-664-5281

IMPROVEMENT PERMIT / AUTHORIZATION TO CONSTRUCT / OPERATION PERMIT / EXISTING SYSTEM INSPECTION

PERMIT# D87198 PIN# 4740328058 PT 4740525184 DATE 4-18-2001

OWNER OR CONTRACTOR Spegas Construction PHONE: Business (704) 636-7954 Home

ADDRESS 607 Anderson Ave Salisbury, NC 28144

LOCATION Clontz Hill Rd TL Stately Pines Dr TL Misty Springs at end on left #145

SUBDIVISION Forest Glen BLOCK / SECTION LOT 21 LOT AREA .51 Acre SITE CLASS. PS DESIGN FLOW 360 gpd L.T.A.R. .25

Septic Tank: 1000 Gallons; STB 825 Date 5-10-03

Pump Tank: 1000 Gallons; PT 302 Date 4-22-03

Pump Make: Zoeller Model N98 Serial No.

Nitrification Field: No Fields Square Feet 1080 Linear Feet 360

No Lines 4 Trench Width 36" Max Trench Bottom Depth 18" Gravel Depth N/A

☒ New System ☐ Repair System Type: I, II, III, IV, V, VI

System Description: Pump-25% Reduction

Repair System Description: Pump-25% Reduction/LPP

Maintenance Agreement Required: ☐ Yes ☒ No

☒ House/Mod. Home No. Bedrooms 3

☐ Mobile Home No. Bathrooms 2

☐ Business No. Employees

☐ Other


☐ Slab ☒ Crawl Space ☐ Basement w/plumbing ☐ Basement wo/plumbing

Water Supply: ☒ Individual ☐ Public ☐ Community


Comments:/Conditions: Shallow Soils on site. Must keep Drainfield shallow to avoid Unsuitable Soils. Start Drainfield 10' off PL. Stay 5' from House & Stay 50' from any well.

Comments:/Conditions: Keep House 15' from right side line Keep well 25' from House & 50' from Septic System. Keep Septic System 50' from Creek Zabel filter installed

Scale 1:50 INITIAL SITE SKETCH

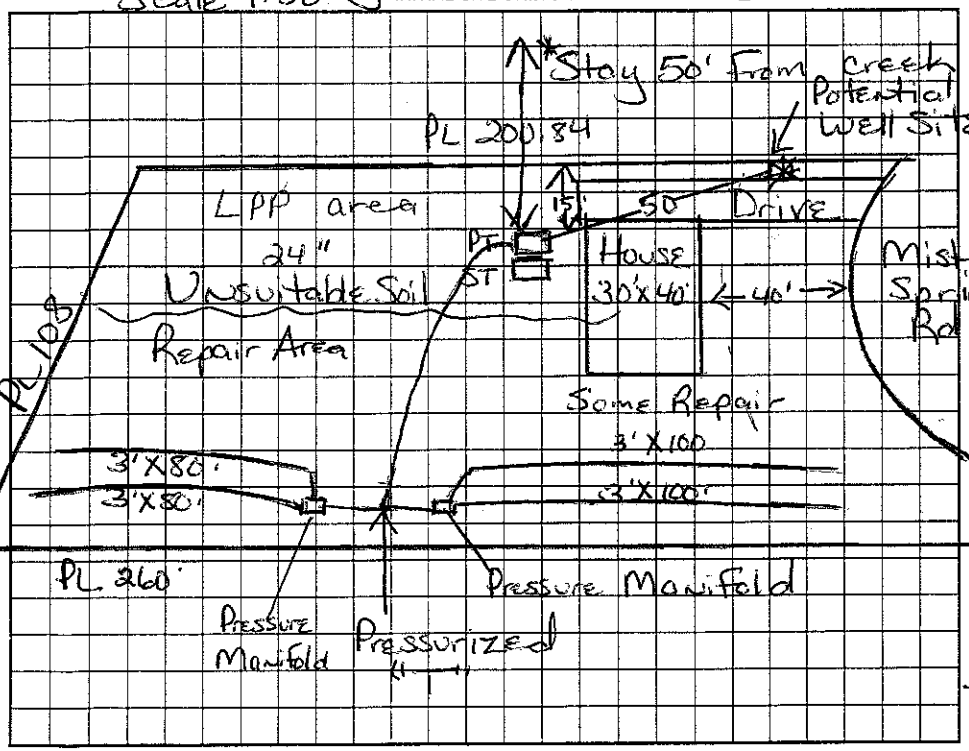

AS BUILT SKETCH

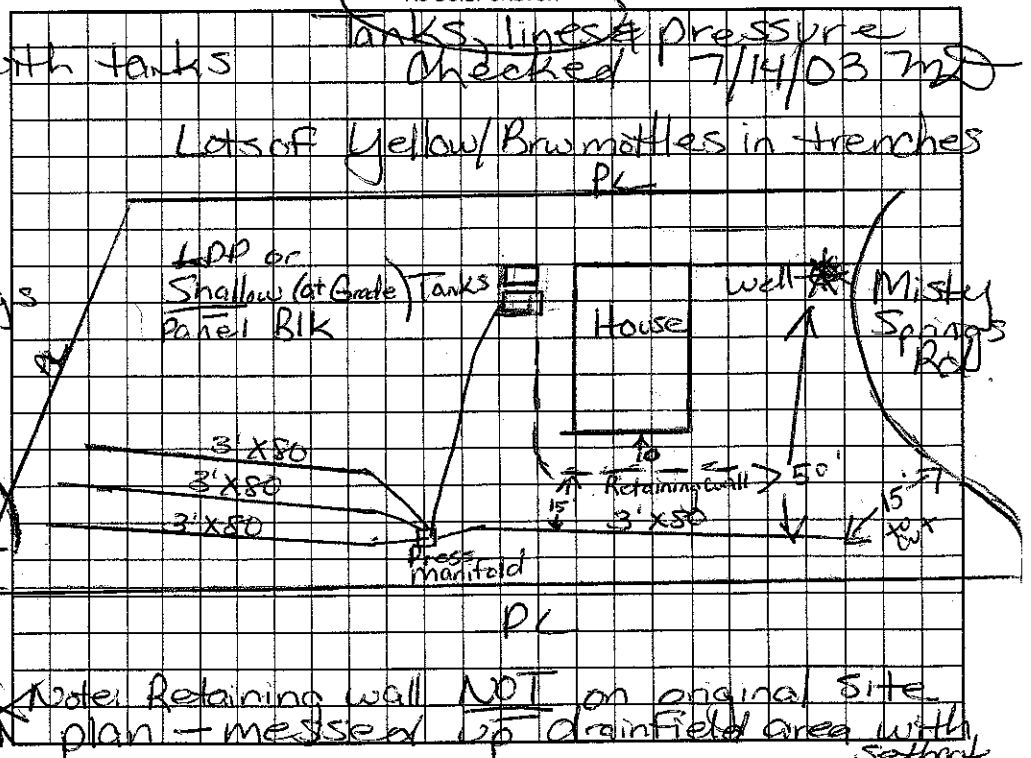

Permit can be suspended or revoked if any false information is supplied toward securing the permit/any unauthorized changes are made to the site/any unauthorized changes are made in the installation of the system. Improvement Permit with plat valid without expiration. Improvement Permit with site plan valid for sixty months. Authorization to Construct is valid for a period equal to that of Improvement Permit – not to exceed sixty months.

Signed: date 5/16/07 Installed by: Rowan Septic RS

Improvement Permit by: Maria H Dotson RS date 4/19/2001 Operation Permit by: Maria Dotson date 7/21/03

Authorization to Construct by: Maria Dotson RS date 4/19/2001 Existing System Inspection by: date

HEALTH DEPT. COPY: WHITE OWNER COPY (FINAL): YELLOW OWNER COPY (INITIAL): PINK