IREDELL COUNTY HEALTH DEPARTMENT

STATESVILLE 704-878-5305 MOORESVILLE 704-664-5281

IMPROVEMENT PERMIT / AUTHORIZATION TO CONSTRUCT / OPERATION PERMIT / EXISTING SYSTEM INSPECTION

PERMIT# 087197 PIN# 4746328058 PT 4740525275 DATE 1-10-2000

OWNER OR CONTRACTOR Spears Construction PHONE: Business (704) 636-7954 Home

ADDRESS 607 Anderson Ave Salisbury NC 28144

LOCATION Perth Rd TR Houtz Hill TR Stately Pines TL Misty Spring Near End

SUBDIVISION Forest Glen BLOCK / SECTION LOT 20 LOT AREA .51 Acre SITE CLASS PS DESIGN FLOW 360gpd L.T.A.R. .3

Septic Tank: 1000 Gallons; STB 825 Date 4-22-00

Pump Tank: 1000 Gallons; PT 302 Date 5-3-00

Pump Make: Model Serial No.

Nitrification Field: No Fields 1 Square Feet 900' Linear Feet 300'

No Lines 3 at 100' Trench Width 36" Max Trench Bottom Depth 36" Gravel Depth N/A

☒ New System ☐ Repair System Type: I, II, III, IV, V, VI

System Description: Pump (PM) 25% Reduction

Repair System Description: Same

Maintenance Agreement Required: ☐ Yes ☒ No

☒ House/Mod. Home ☐ Mobile Home ☐ Business ☐ Other

No. Bedrooms 3 No. Bathrooms 2 No. Employees


☐ Slab ☐ Crawl Space ☐ Basement w/plumbing ☐ Basement wo/plumbing

Water Supply: ☒ Individual ☐ Public ☐ Community

Comments:/Conditions: Keep Septic System 10' From PL & out of Septic Easement area. Keep off least 50' Separation between Septic System (Tanks & lines) and well.

Comments:/Conditions: Note: If plumbing can be stubbed out at high end of house, Septic System may not have to be pumped. Filter installed. Tanks, lines & pressure inspected 6/22/00

INITIAL SITE SKETCH Scale 1:50"

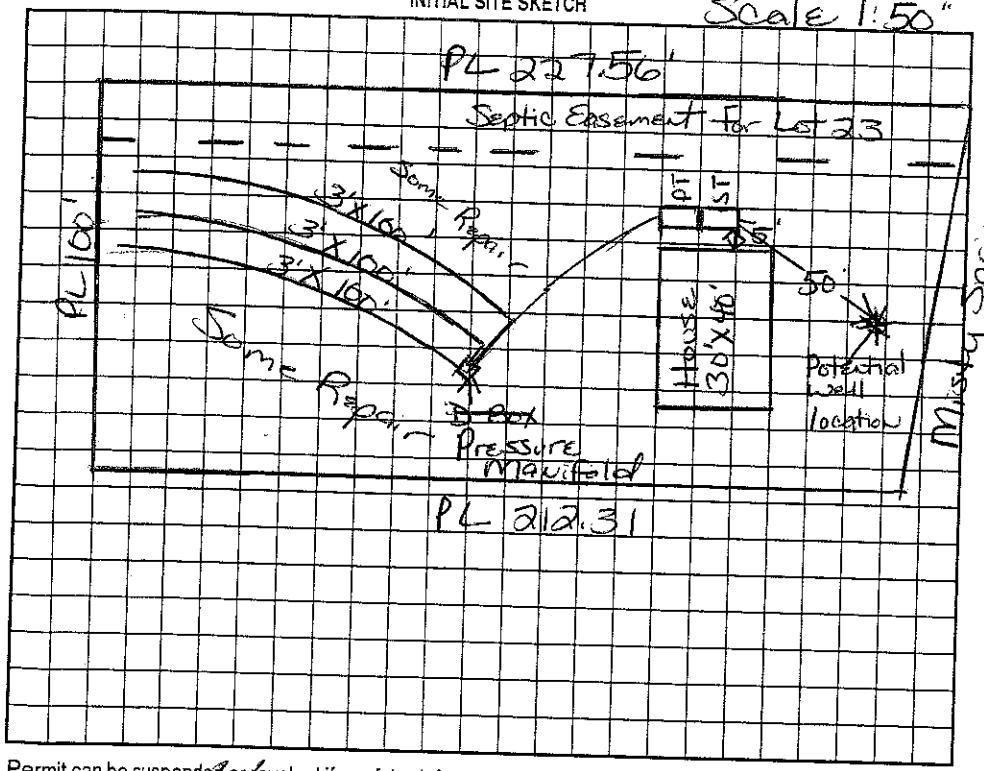

AS BUILT SKETCH

Installed as Drawn 6/28/00

ST lid Cracked, asked Max Jr to replace

Permit can be suspended or revoked if any false information is supplied toward securing the permit/any unauthorized changes are made to the site/any unauthorized changes are made in the installation of the system. Improvement Permit with plat valid without expiration. Improvement Permit with site plan valid for sixty months. Authorization to Construct is valid for a period equal to that of Improvement Permit – not to exceed sixty months.

Signed: date 1/14/00

Improvement Permit by: Maria H. Dolson RS date 1/11/2000

Authorization to Construct by: Maria H. Dolson date 1/11/2000

Installed by: Rowan Septic

Operation Permit by: Maria H. Dolson RS date 6/28/2000

Existing System Inspection by: date

HEALTH DEPT. COPY: WHITE OWNER COPY (FINAL): YELLOW OWNER COPY (INITIAL): PINK